

0376-240

N 65700

D. J. G. SURVEYOR 5-3-93
R. J. G. reg. manager 5/3/93.

N 65650

N 65600

N 65550

E 44300

E 44300










E 44250

E 44250

N 65700

N 65650

N 65600

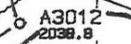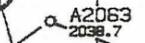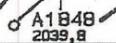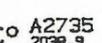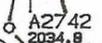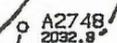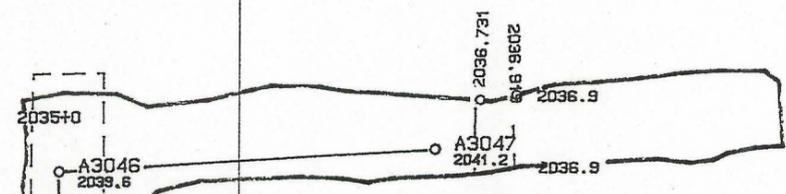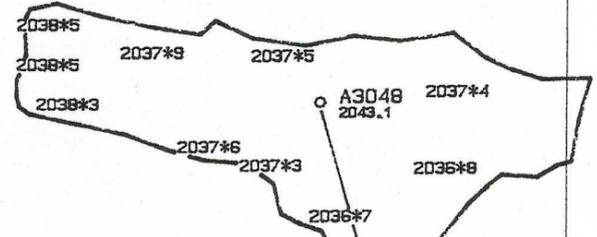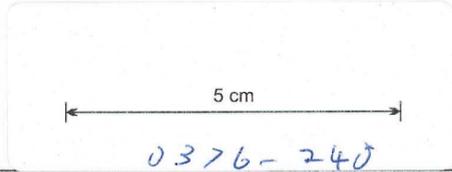

RENISON LIMITED

FEDERAL 2035 NORTH
PERIOD 8 WEEK 4

WEST COAST SURVEYS PTY LTD

Scale 1:500 | Survey Ext 225 | 23-FEB-93

FEDERF.PF