

0376-242


*Dudge* SURVEYOR 5-3-93  
*V.K.K.* reg. manager 5/3/93



2122.6  
2126.6

2A FILL RISE

2A VENT RISE

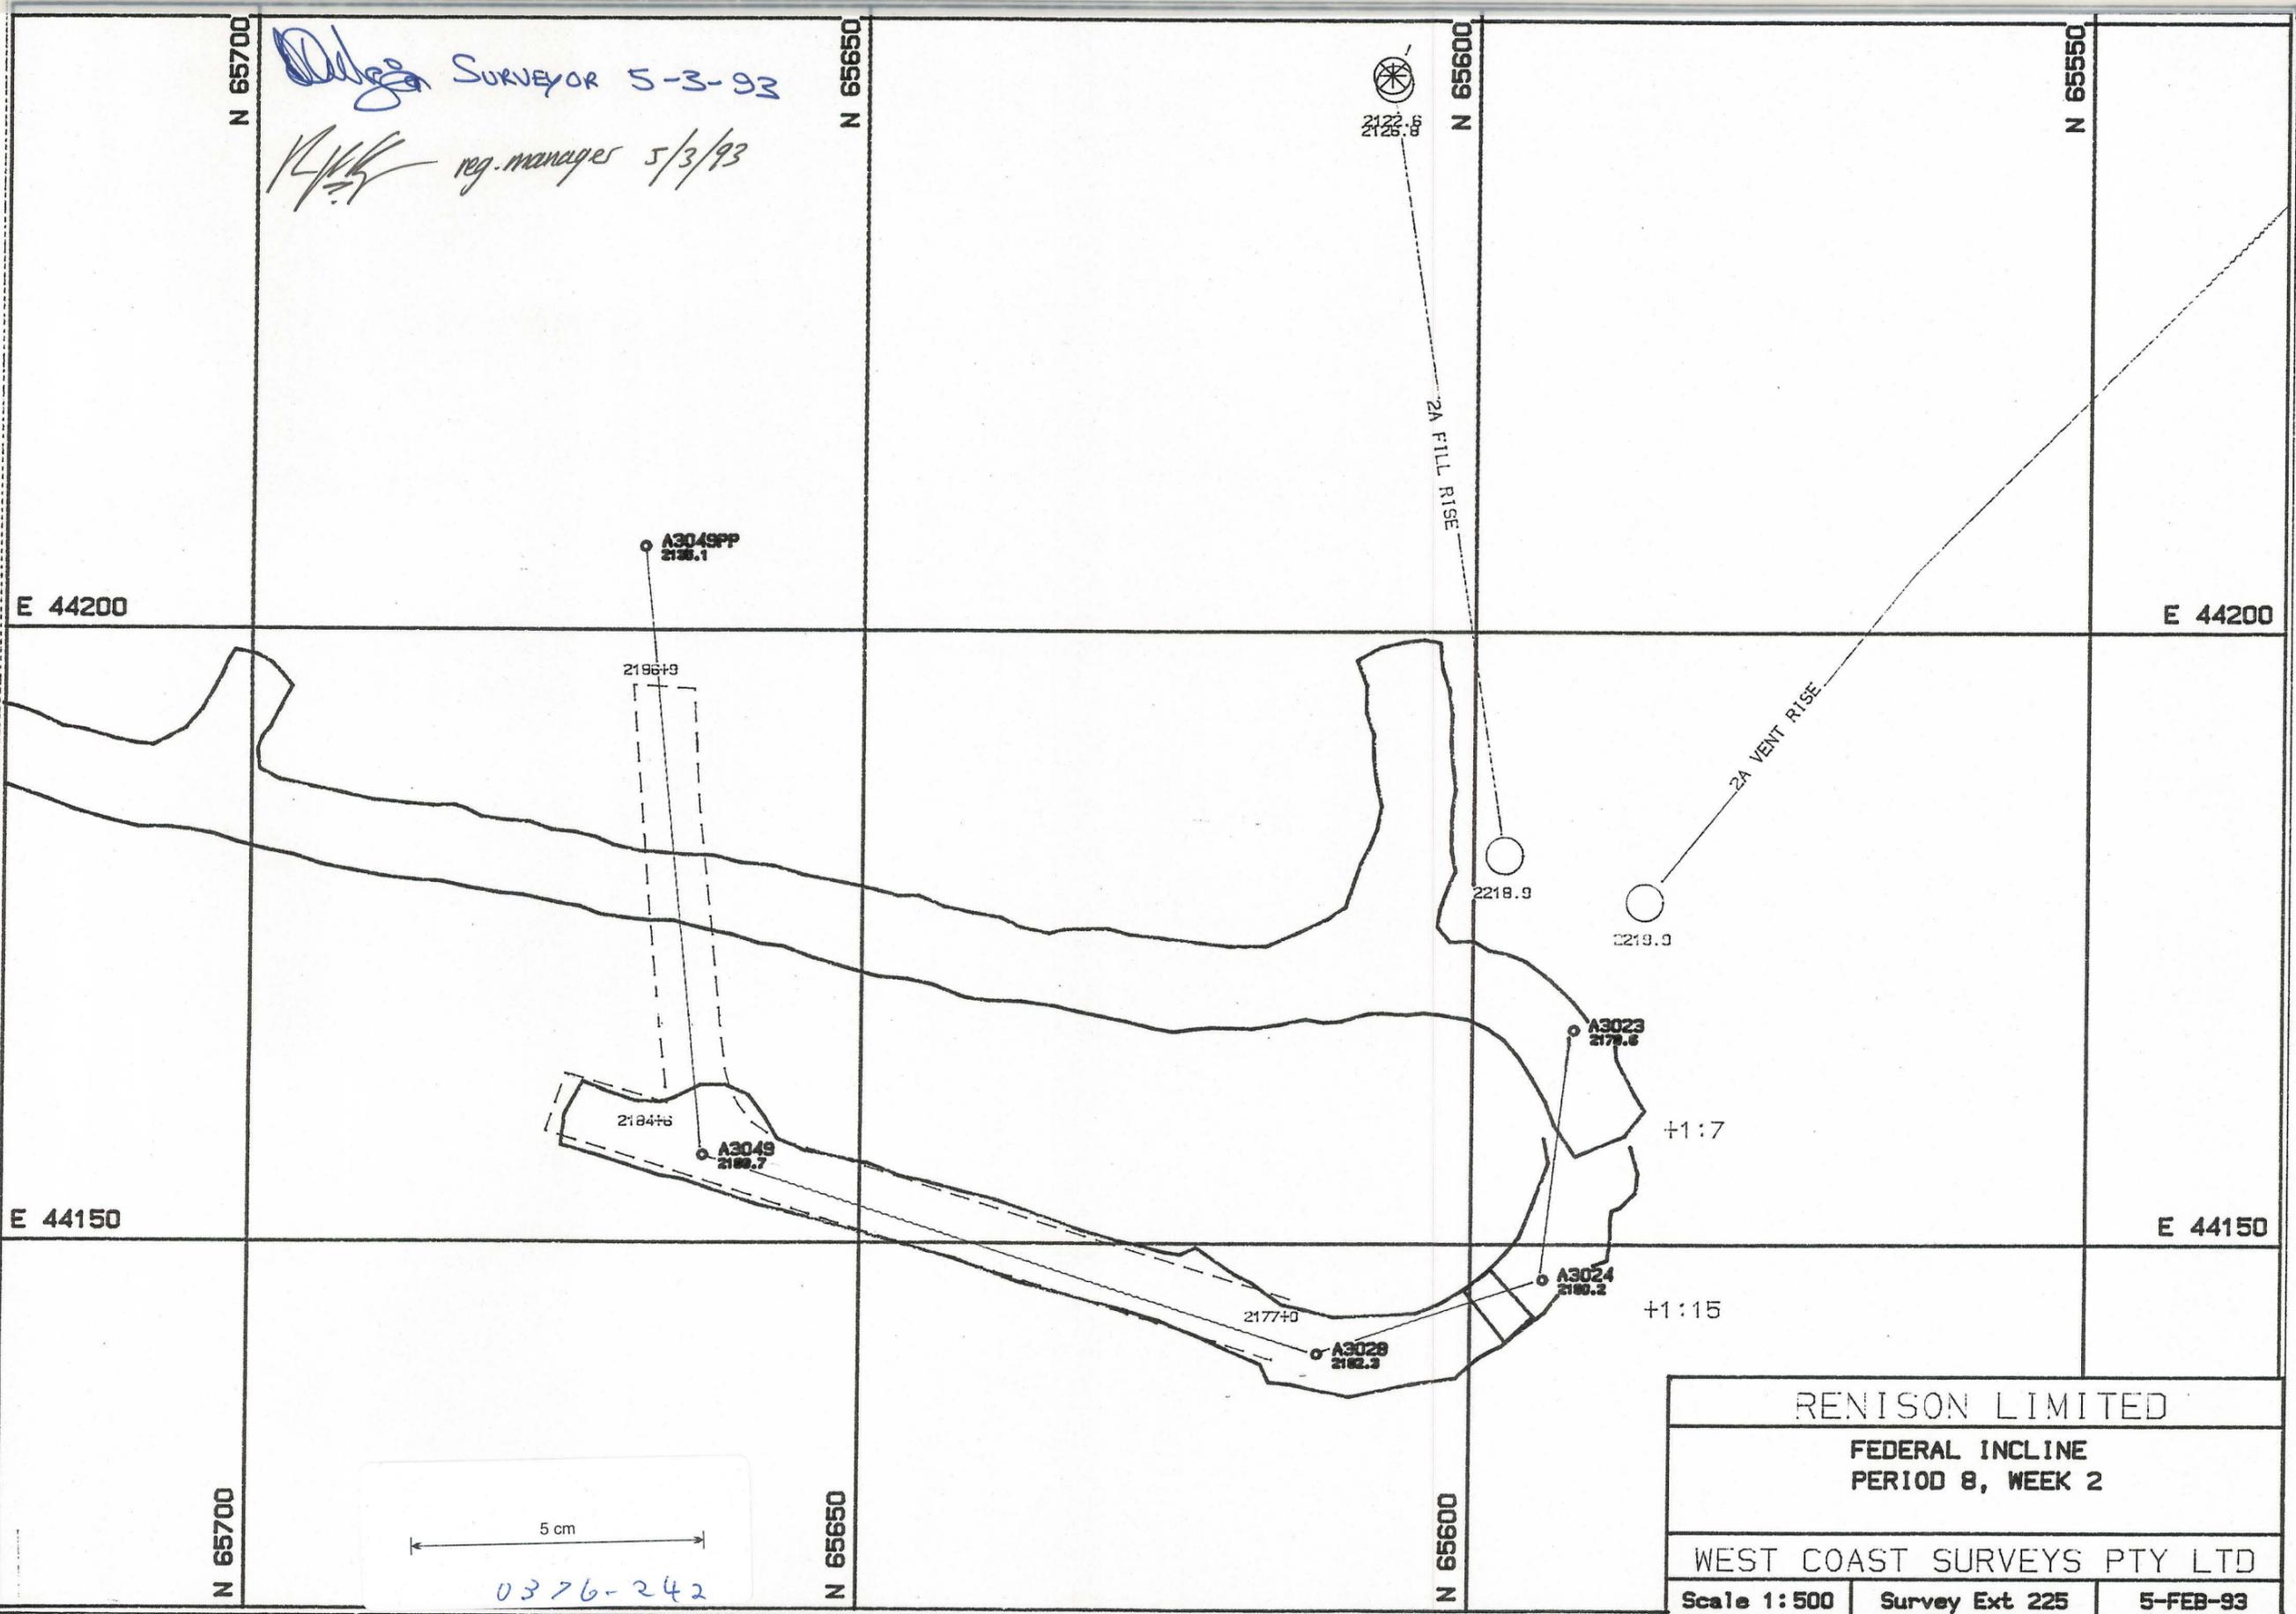

|                                     |                |          |
|-------------------------------------|----------------|----------|
| RENISON LIMITED                     |                |          |
| FEDERAL INCLINE<br>PERIOD 8, WEEK 2 |                |          |
| WEST COAST SURVEYS PTY LTD          |                |          |
| Scale 1:500                         | Survey Ext 225 | 5-FEB-93 |

5 cm  
0376-242

FEDERB.PF