


0376-243

Argent SURVEYOR 5-3-93
R. J. G. reg. manager 5/3/93

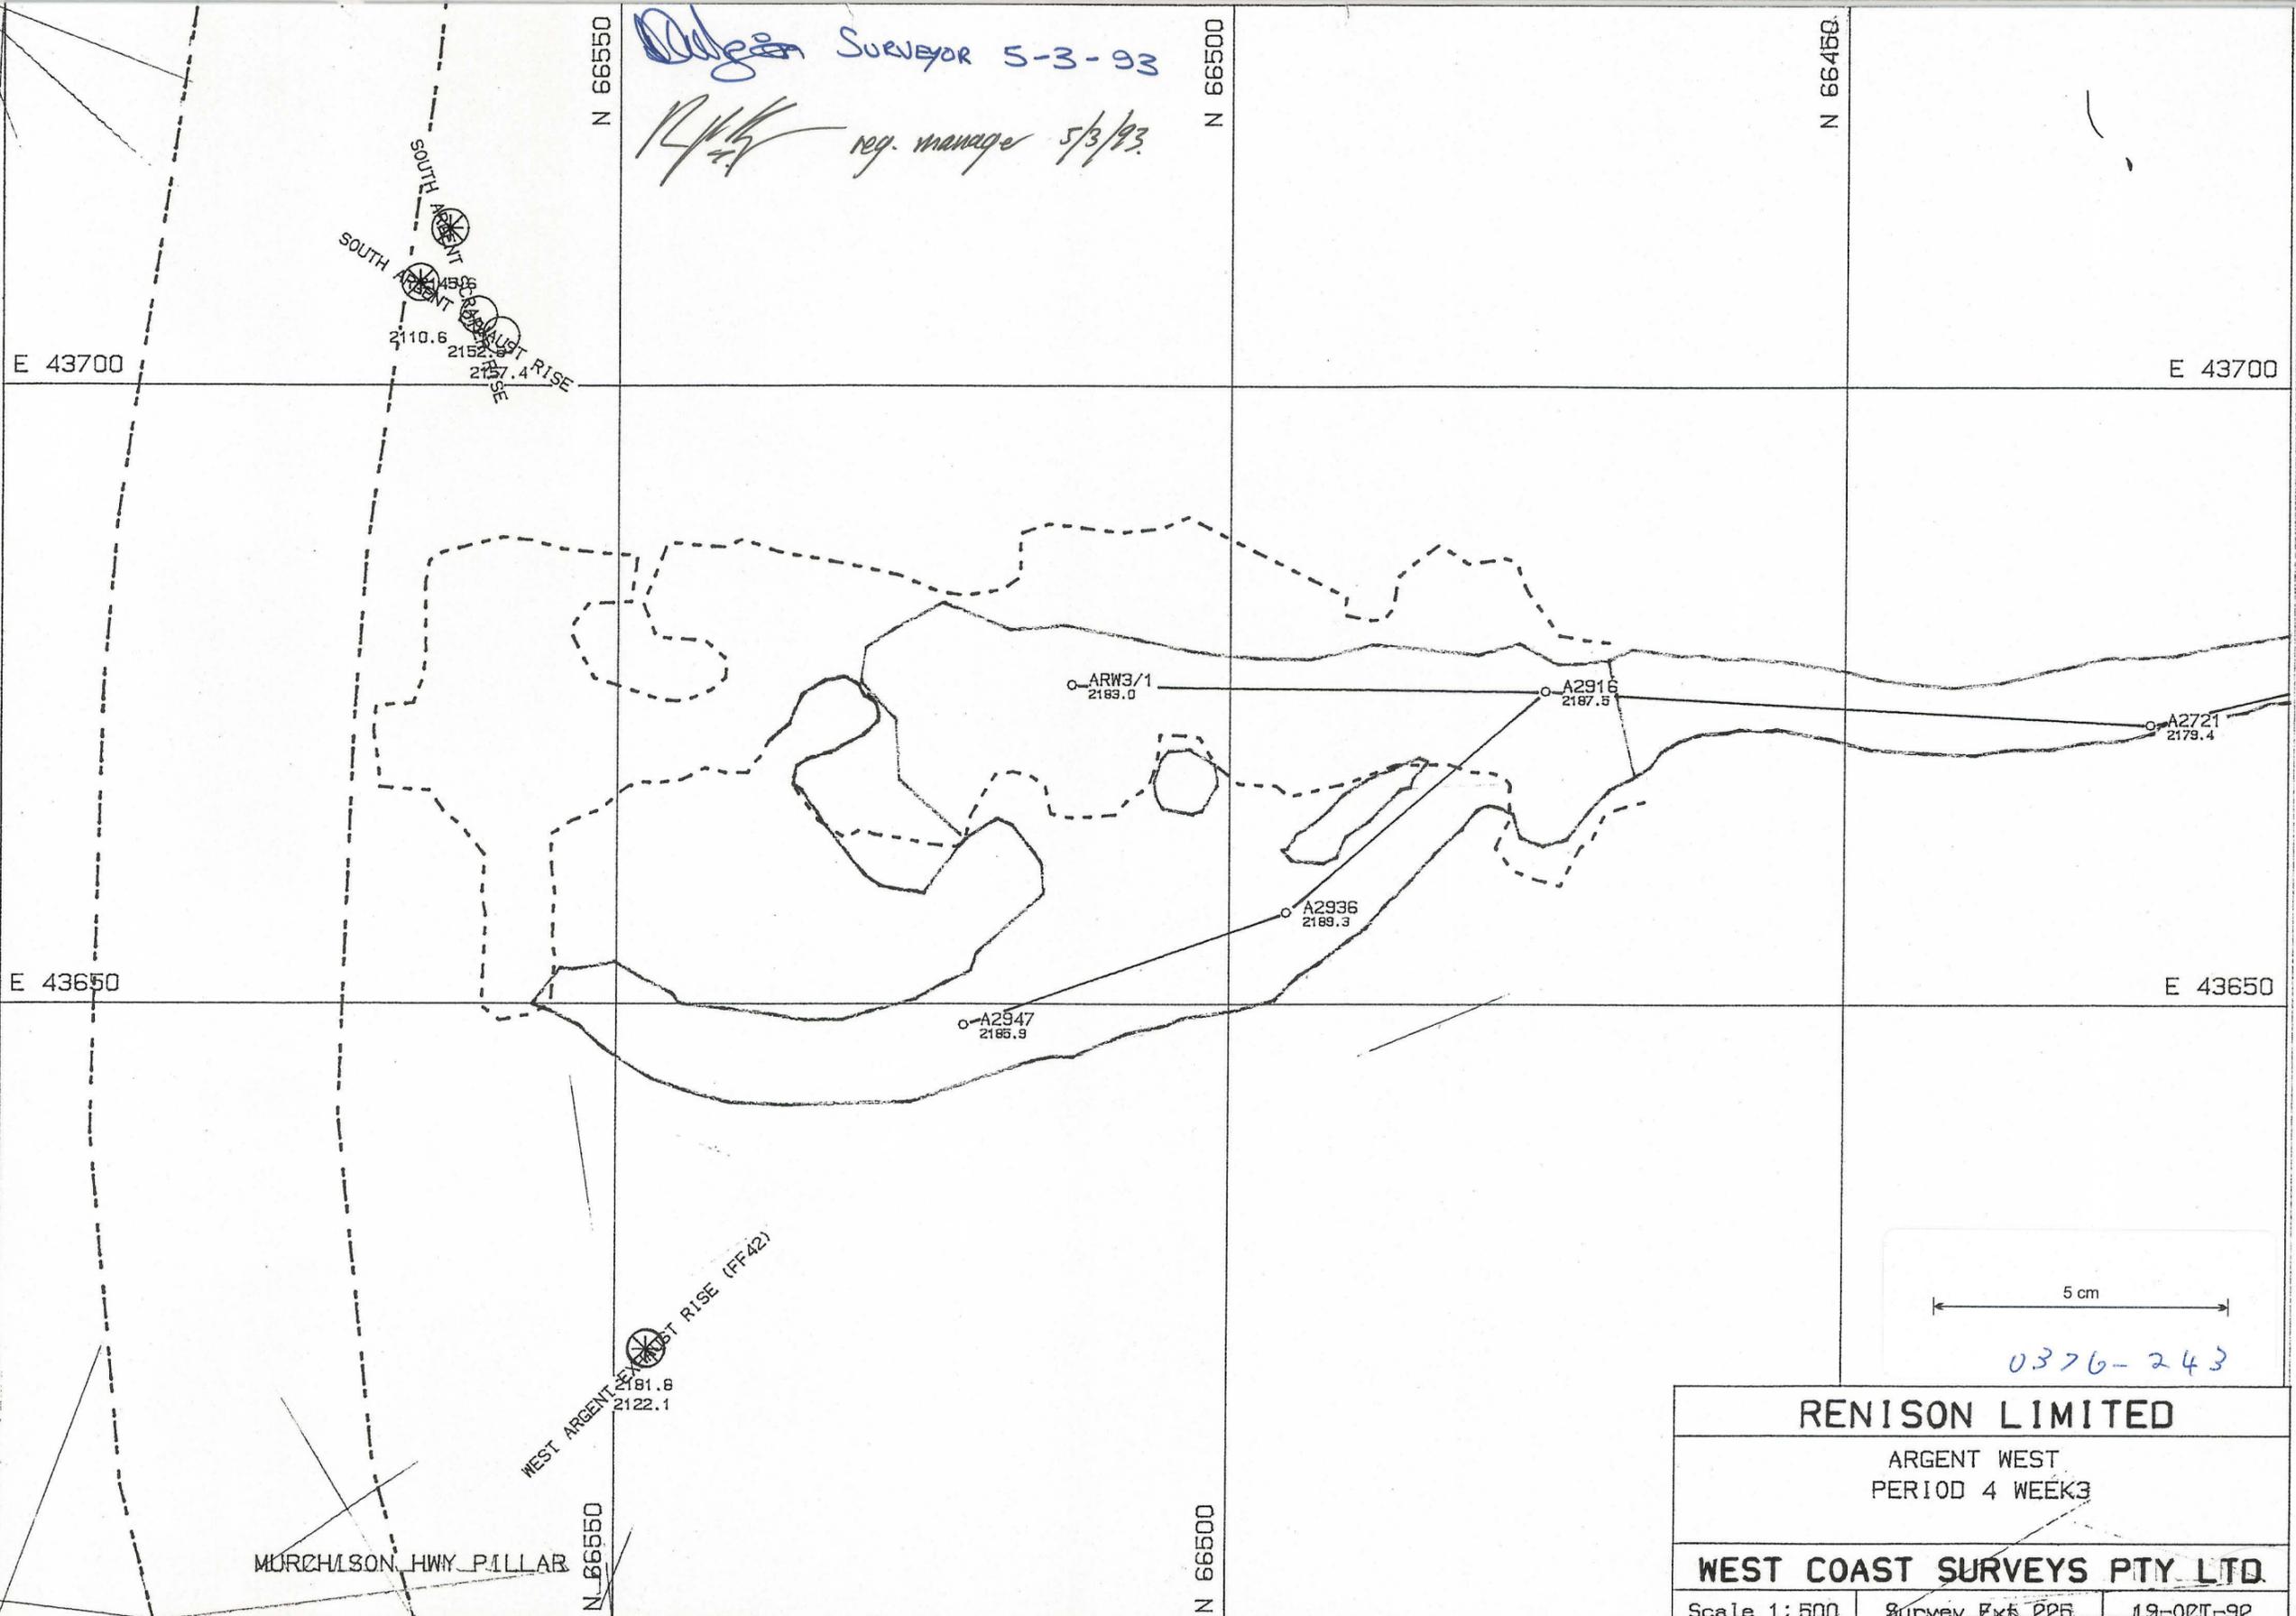

5 cm
0376-243

RENISON LIMITED		
ARGENT WEST PERIOD 4 WEEK3		
WEST COAST SURVEYS PTY LTD		
Scale 1:500	Survey Exs 225	19-0211-92

ARGENT - PK