


0376-244

N

Dulgan Surveyor 5-3-93
R. W. H. reg. manager 5/3/93.

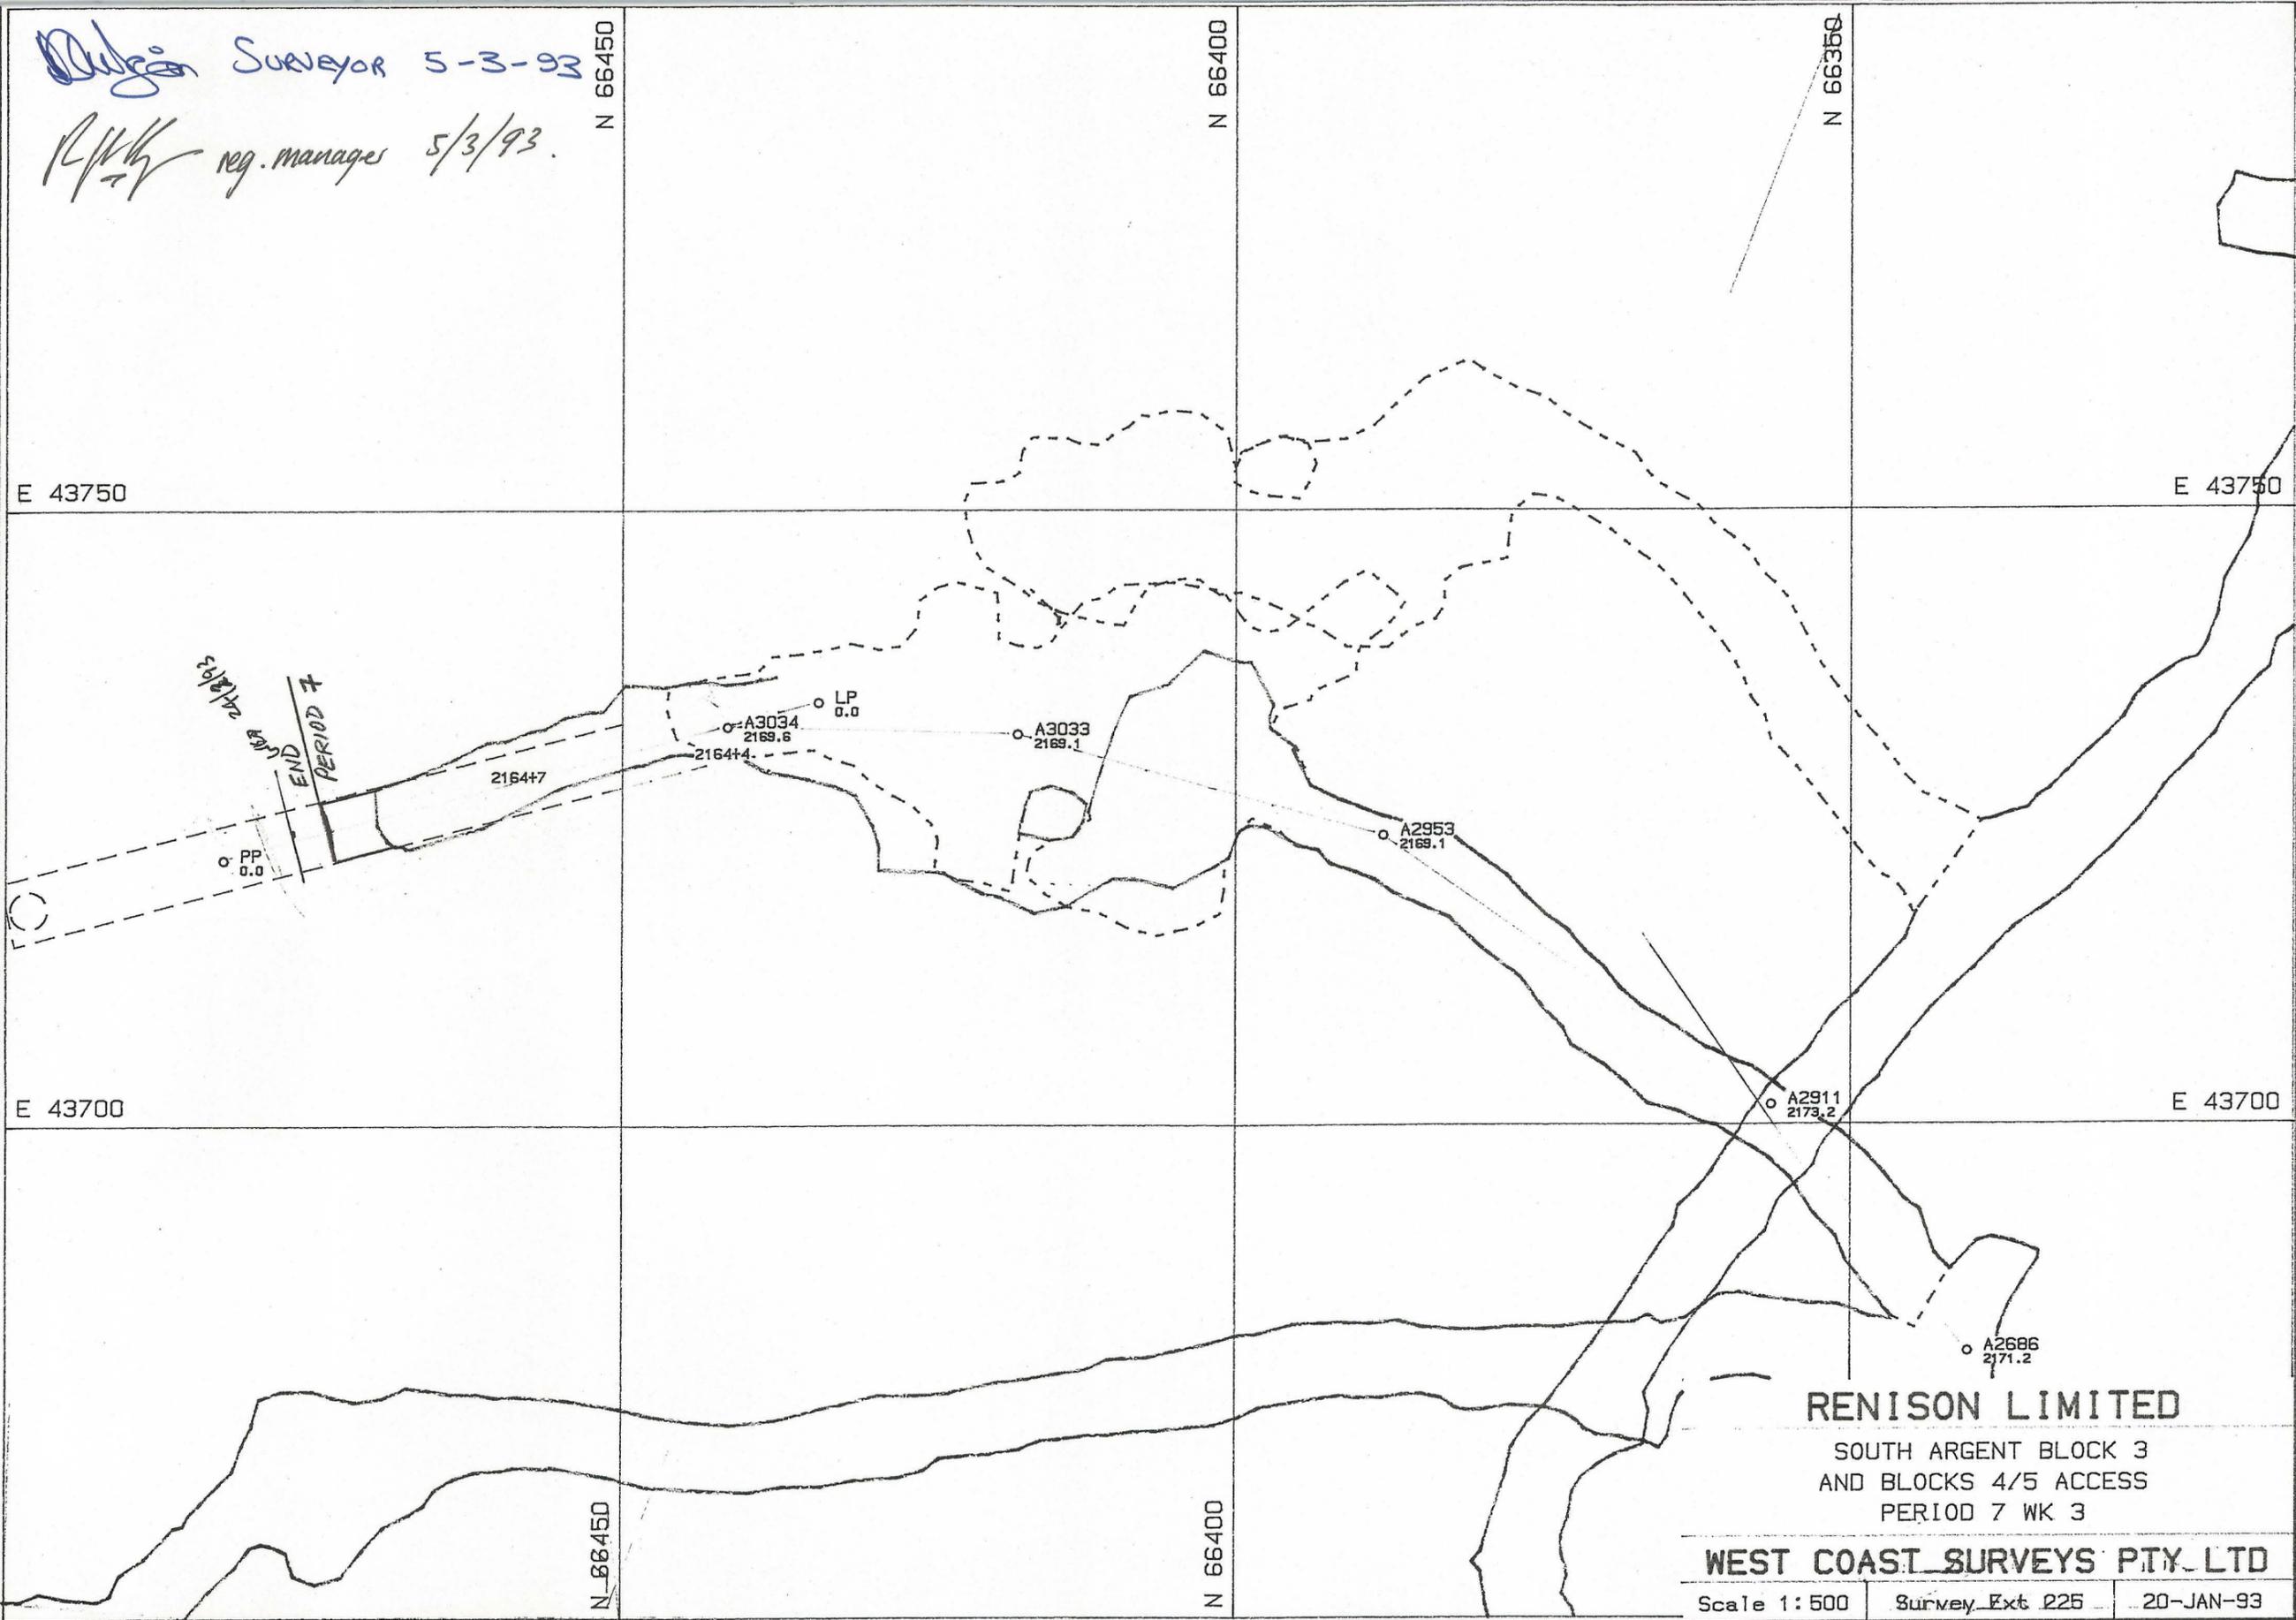

0376-244
5 cm

RENISON LIMITED

SOUTH ARGENT BLOCK 3
AND BLOCKS 4/5 ACCESS
PERIOD 7 WK 3

WEST COAST SURVEYS PTY. LTD

Scale 1:500 Survey Ext 225 20-JAN-93