


0376-245

2

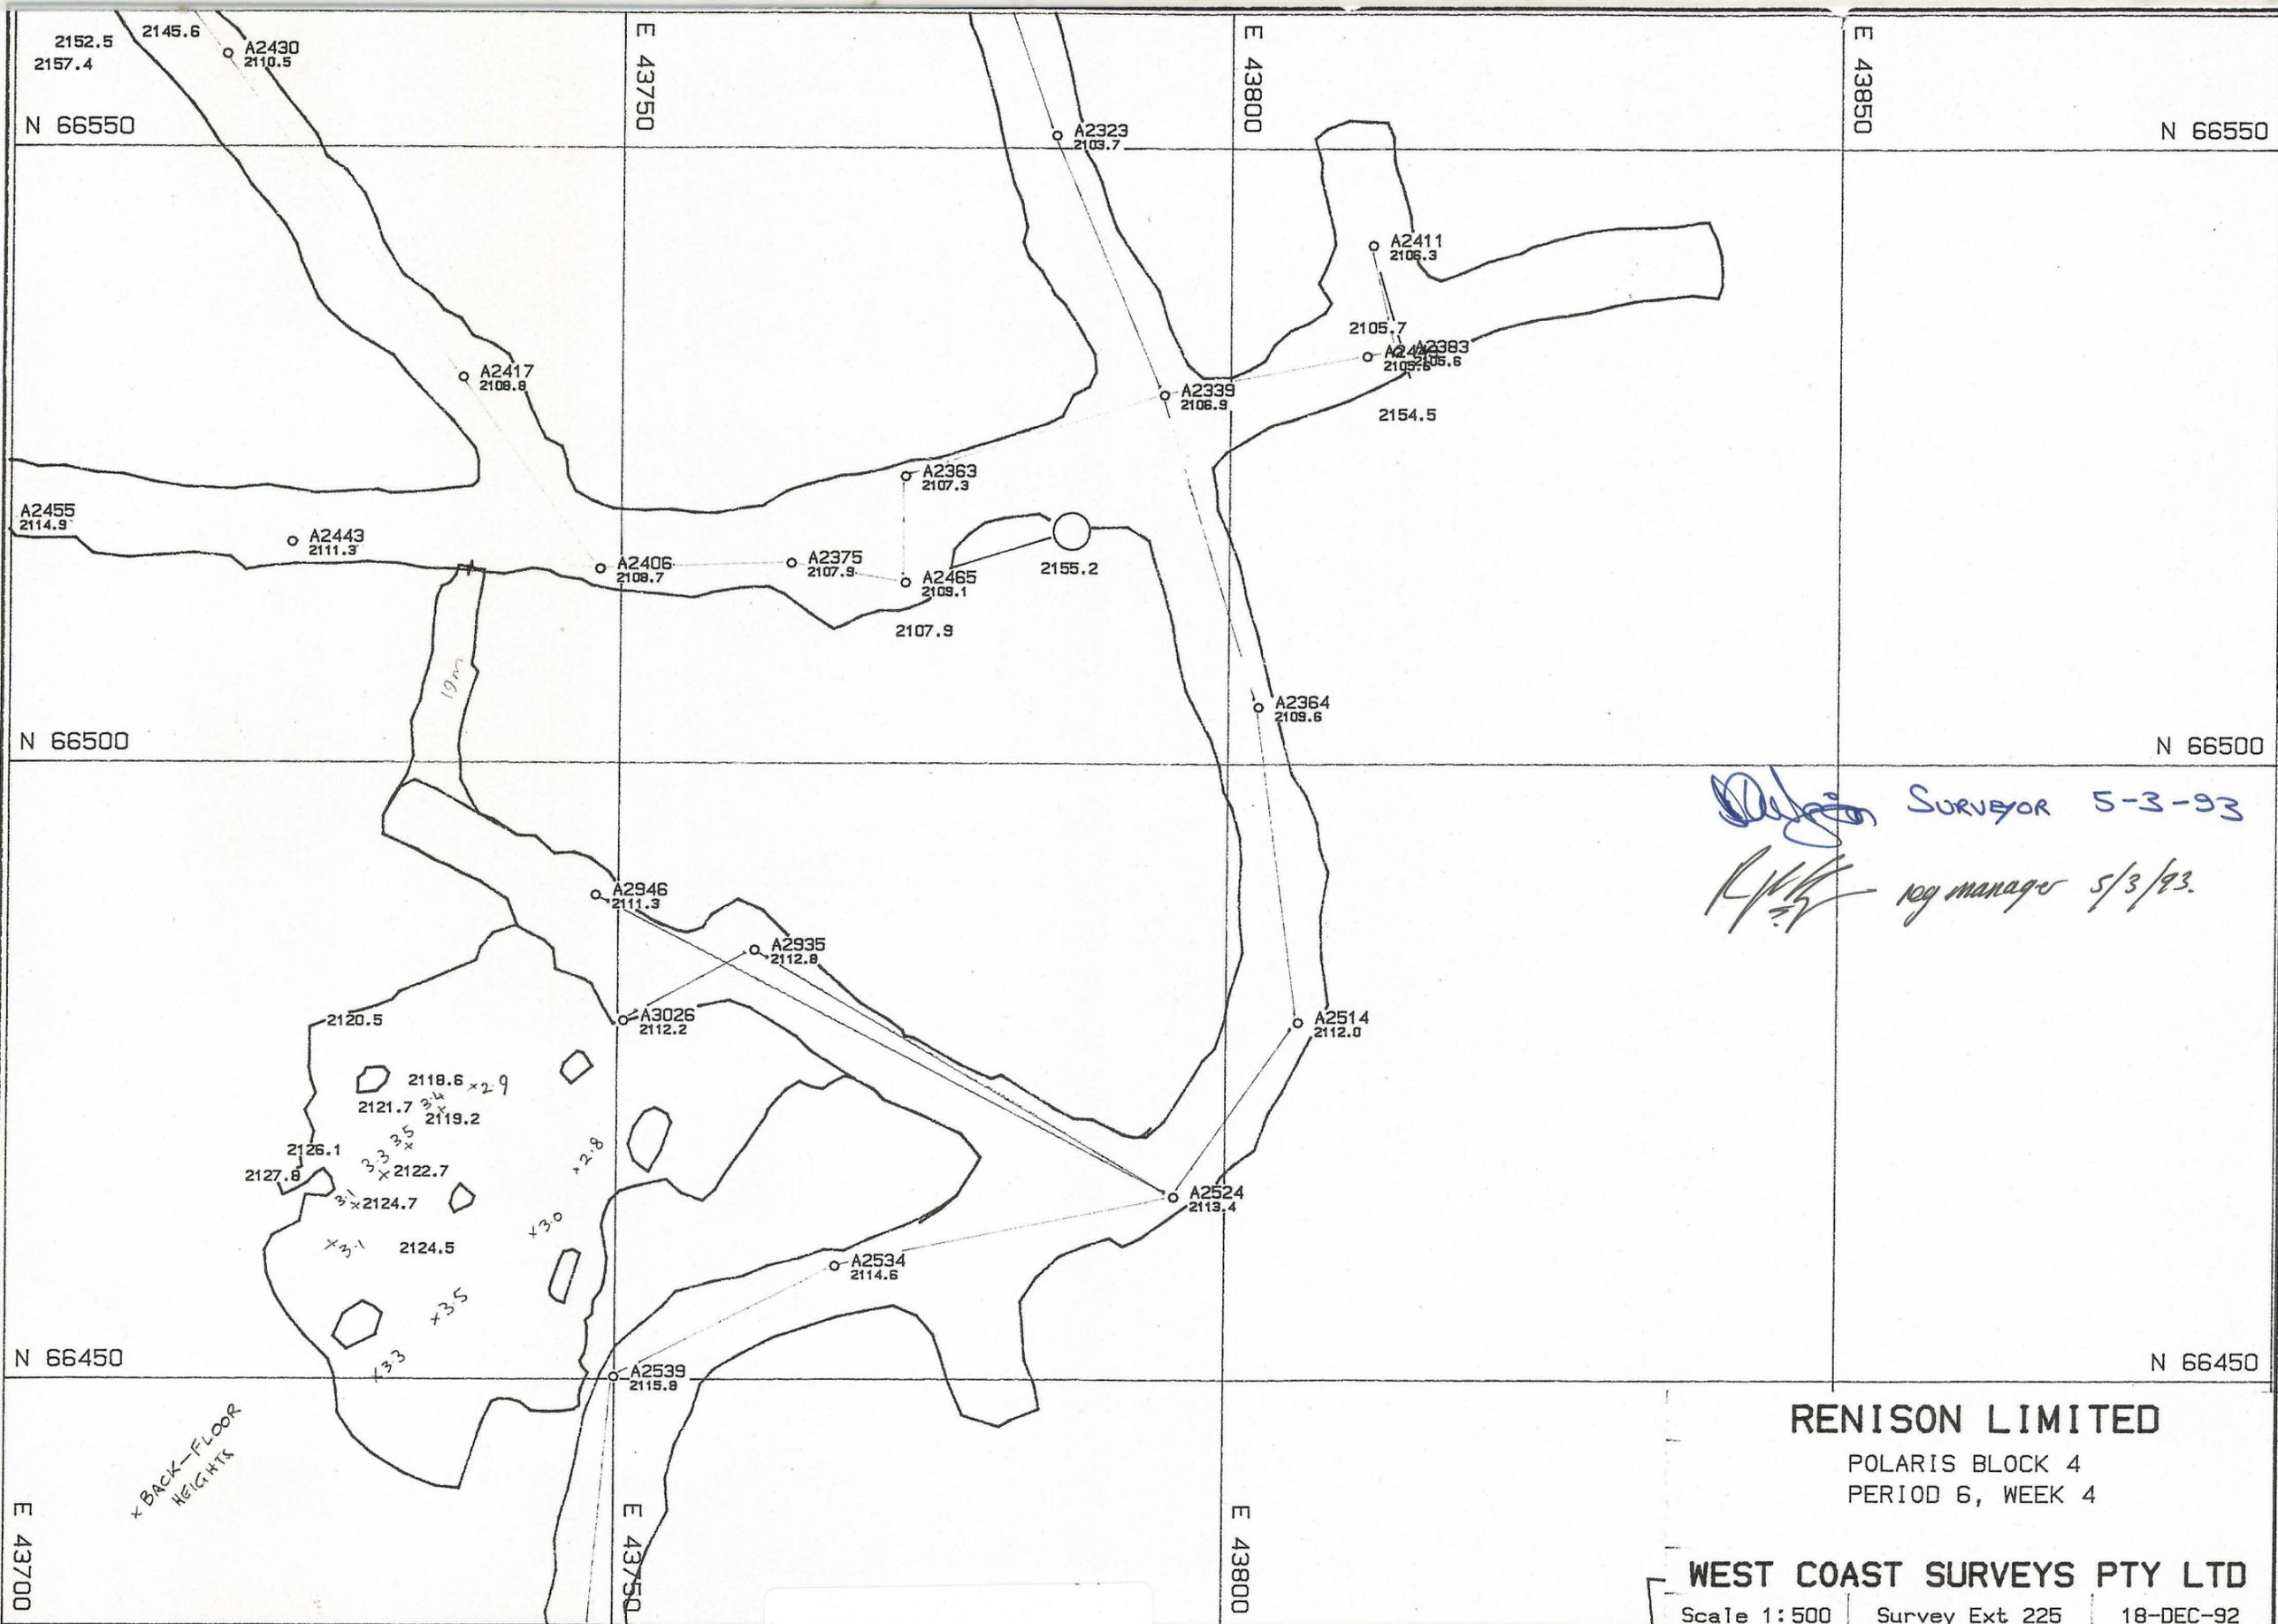

*[Signature]* SURVEYOR 5-3-93  
*[Signature]* log manager 5/3/93

**RENISON LIMITED**

POLARIS BLOCK 4  
 PERIOD 6, WEEK 4

**WEST COAST SURVEYS PTY LTD**

Scale 1:500 | Survey Ext 225 | 18-DEC-92

POLARA.PF

5 cm  
 0376-245