


0376-246

N

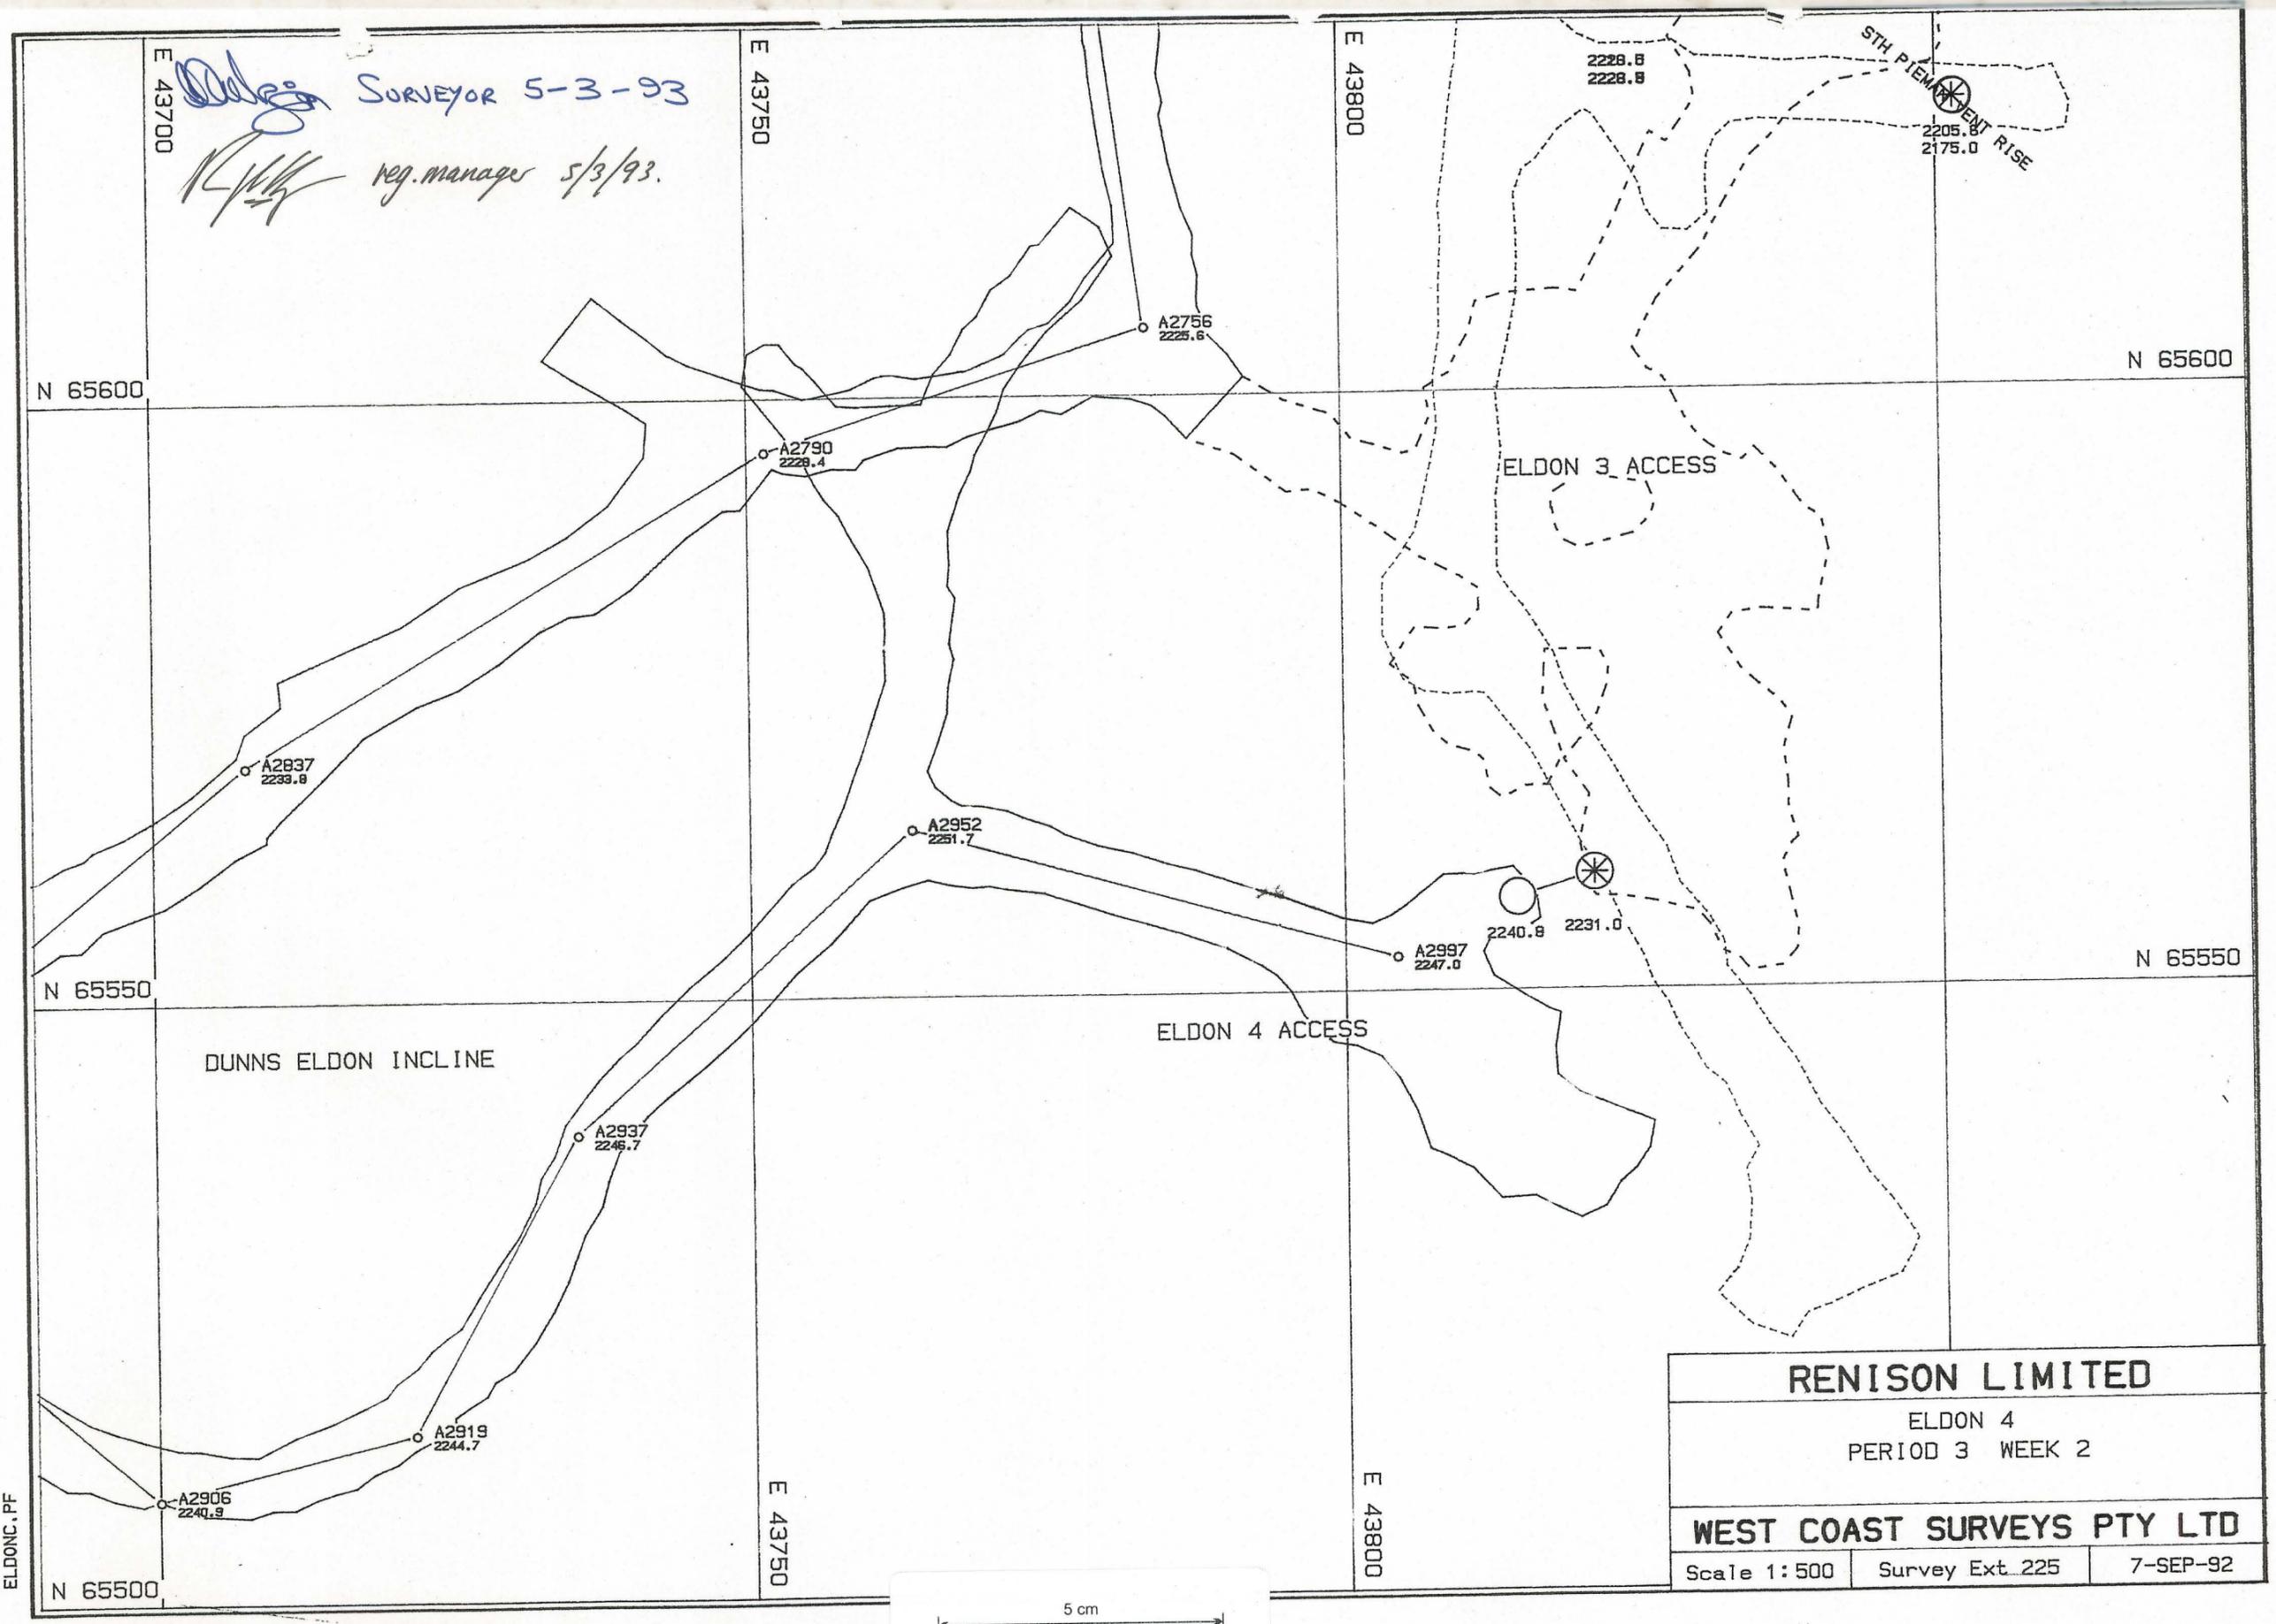

<b>RENISON LIMITED</b>		
ELDON 4 PERIOD 3 WEEK 2		
<b>WEST COAST SURVEYS PTY LTD</b>		
Scale 1:500	Survey Ext. 225	7-SEP-92

5 cm

0376-246

ELDONC.PF