


0376-247

Surveyor SURVEYOR 5-3-93
reg. manager 5/3/93

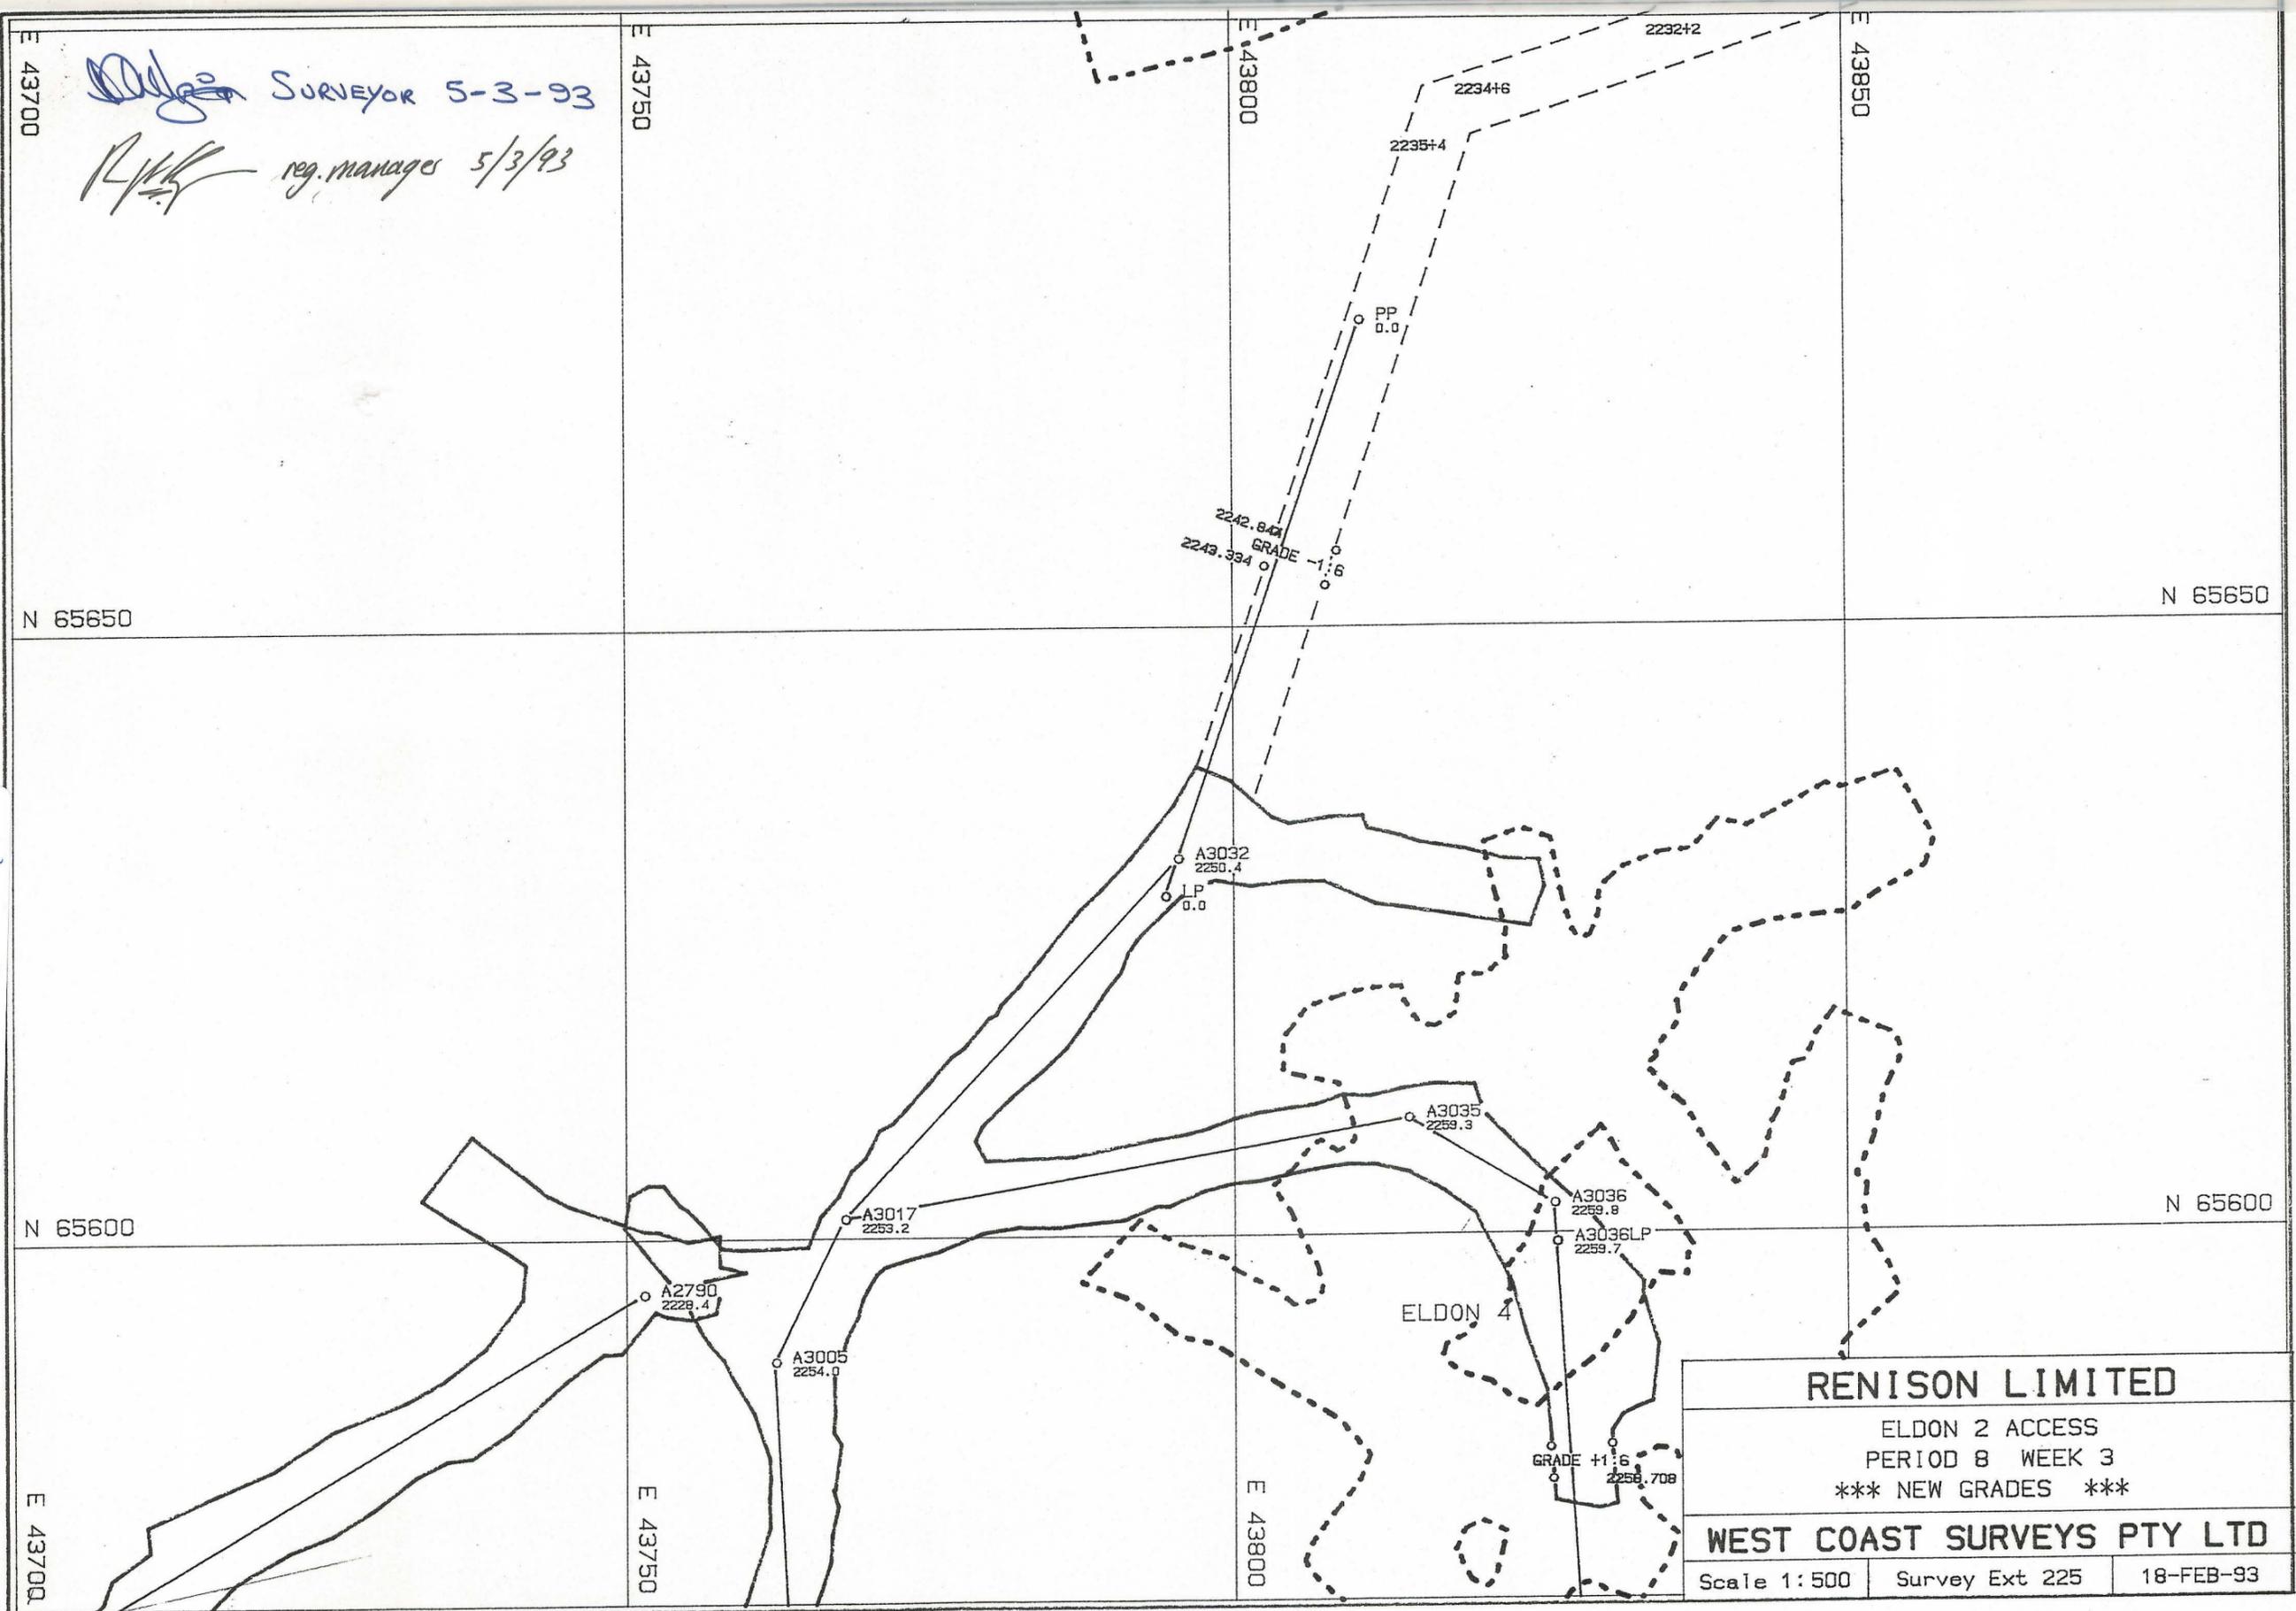

5 cm
0376-247

RENISON LIMITED		
ELDON 2 ACCESS PERIOD 8 WEEK 3 *** NEW GRADES ***		
WEST COAST SURVEYS PTY LTD		
Scale 1:500	Survey Ext 225	18-FEB-93

ELDONA, PF
E 43700