


0376-248

Dunns SURVEYOR 5-3-93
R.J.K. reg. manage 5/3/93

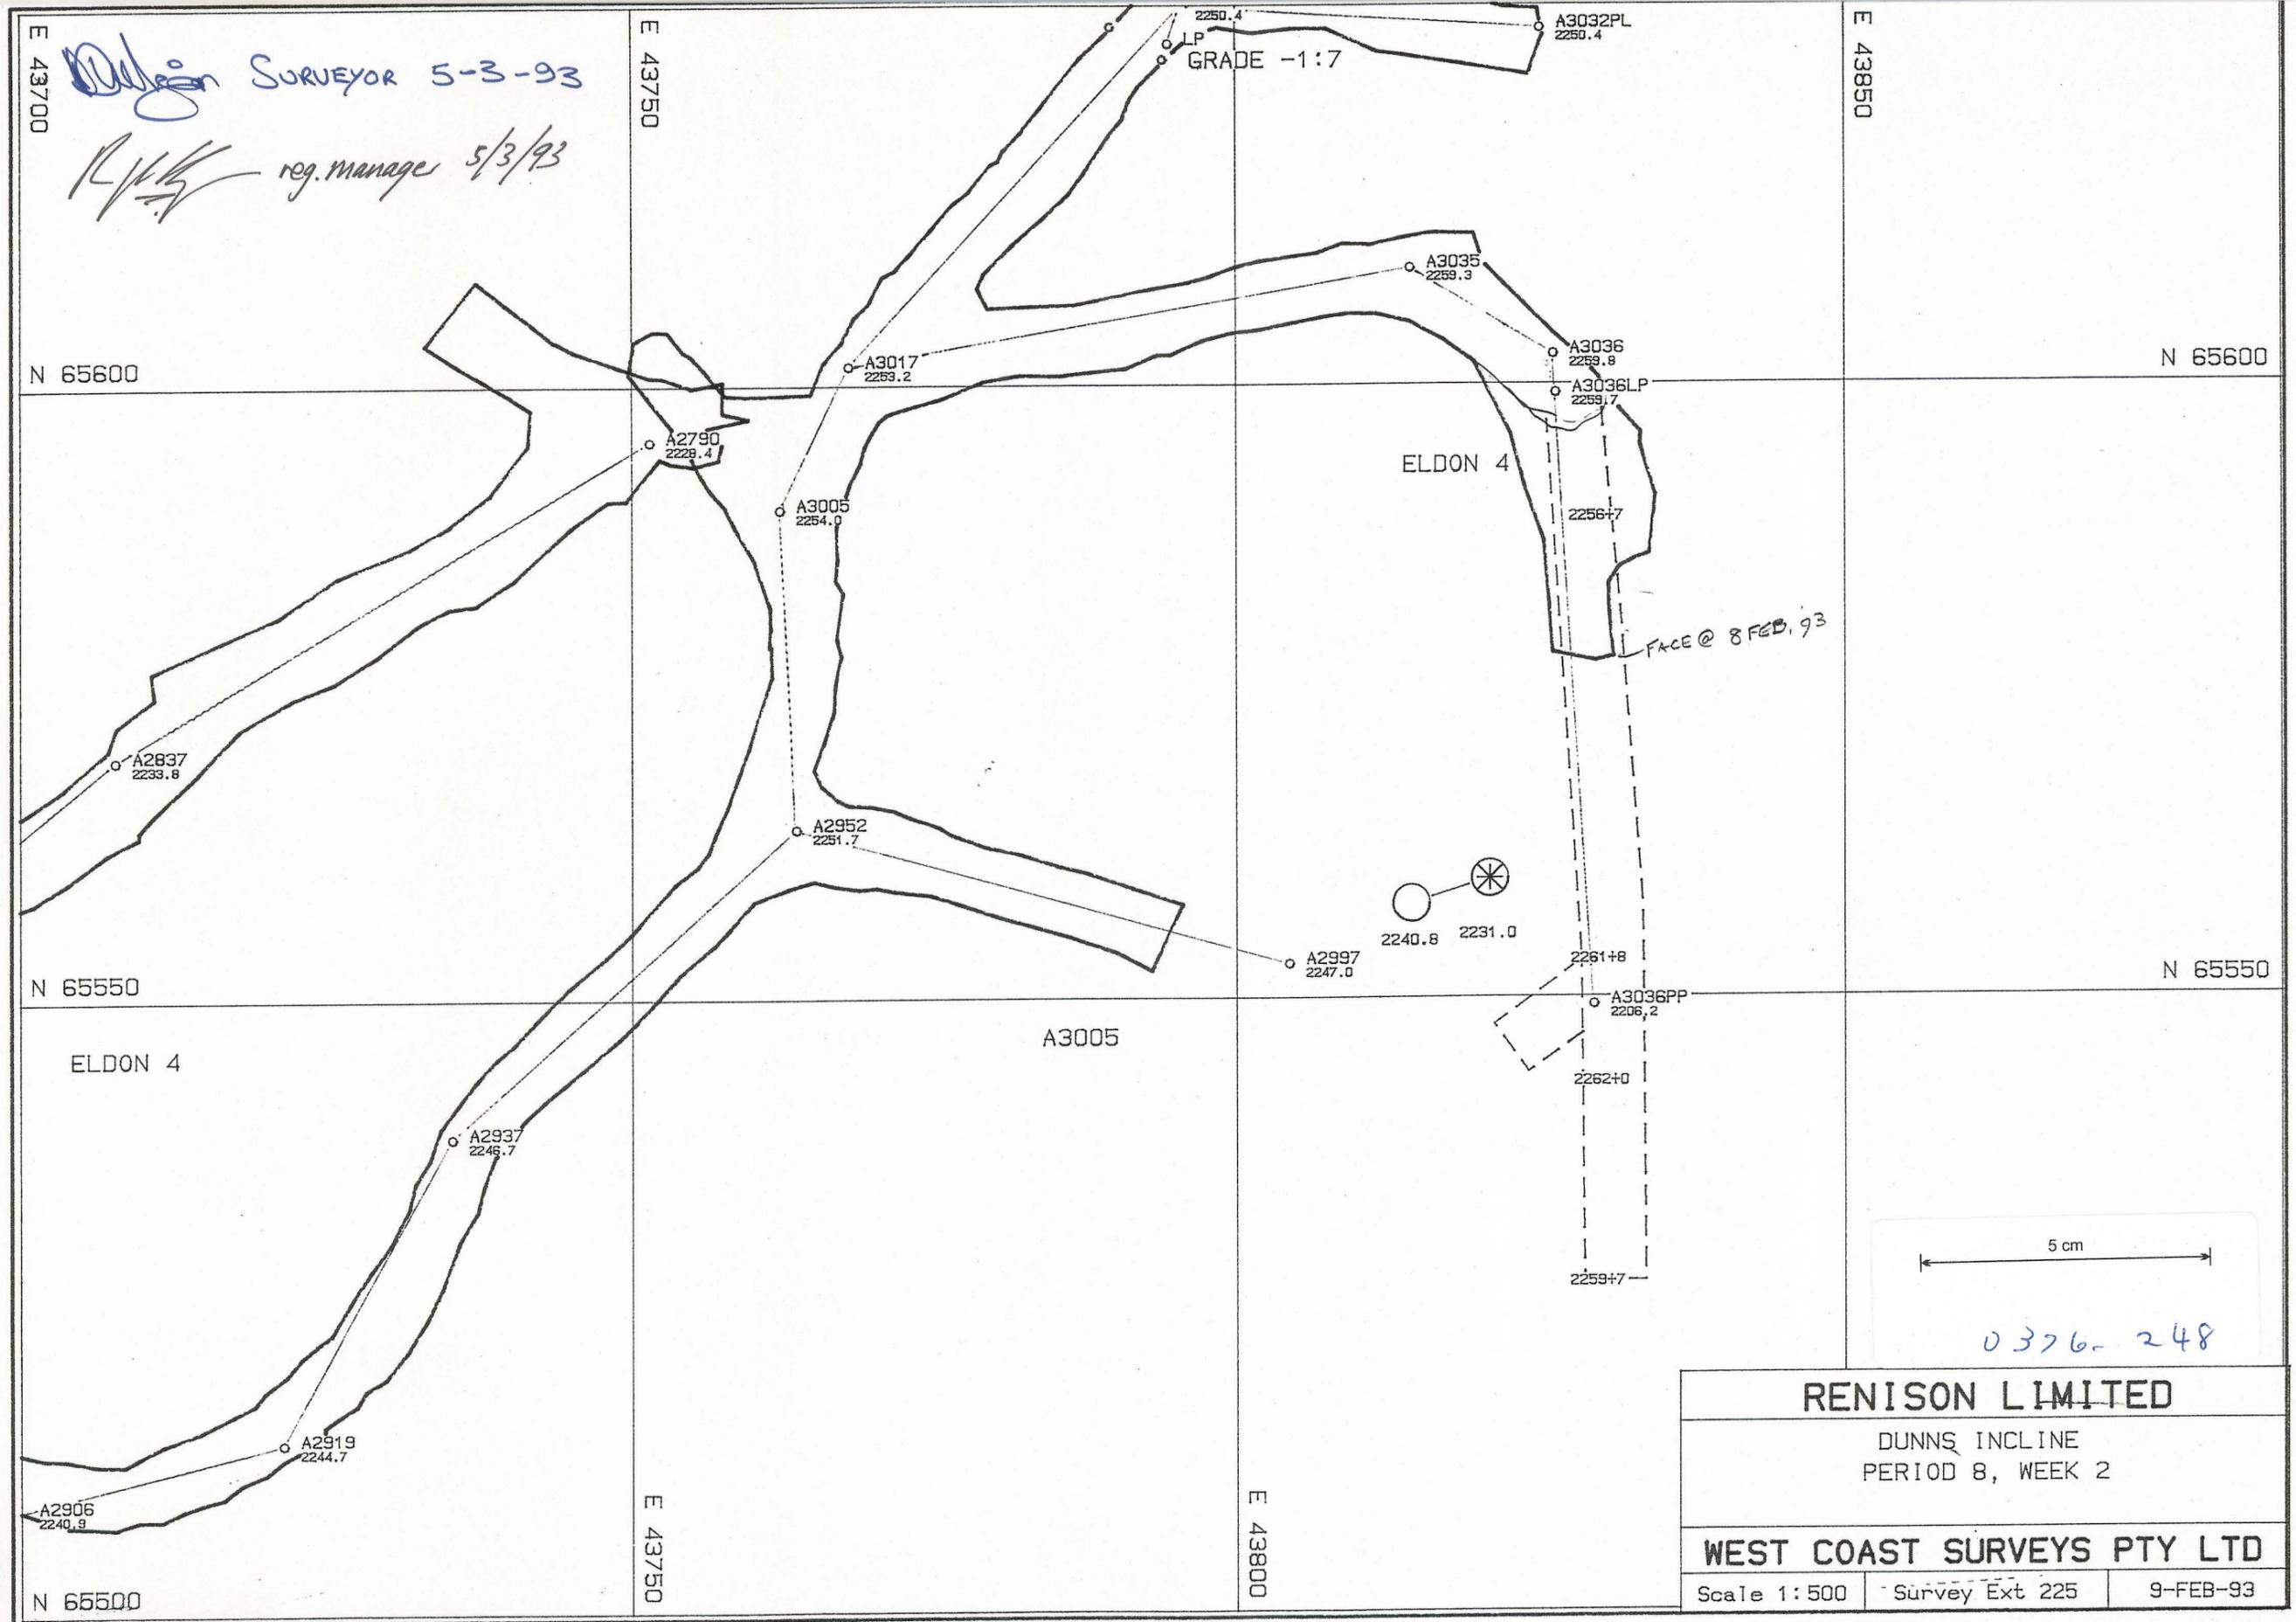

5 cm
0376-248

| | | |
|-----------------------------------|----------------|----------|
| RENISON LIMITED | | |
| DUNNS INCLINE PERIOD 8, WEEK 2 | | |
| WEST COAST SURVEYS PTY LTD | | |
| Scale 1:500 | Survey Ext 225 | 9-FEB-93 |

DUNNSA.PF