



0376-249

2

Oliver SURVEYOR 5-3-93
R/K reg. manager 5/3/93

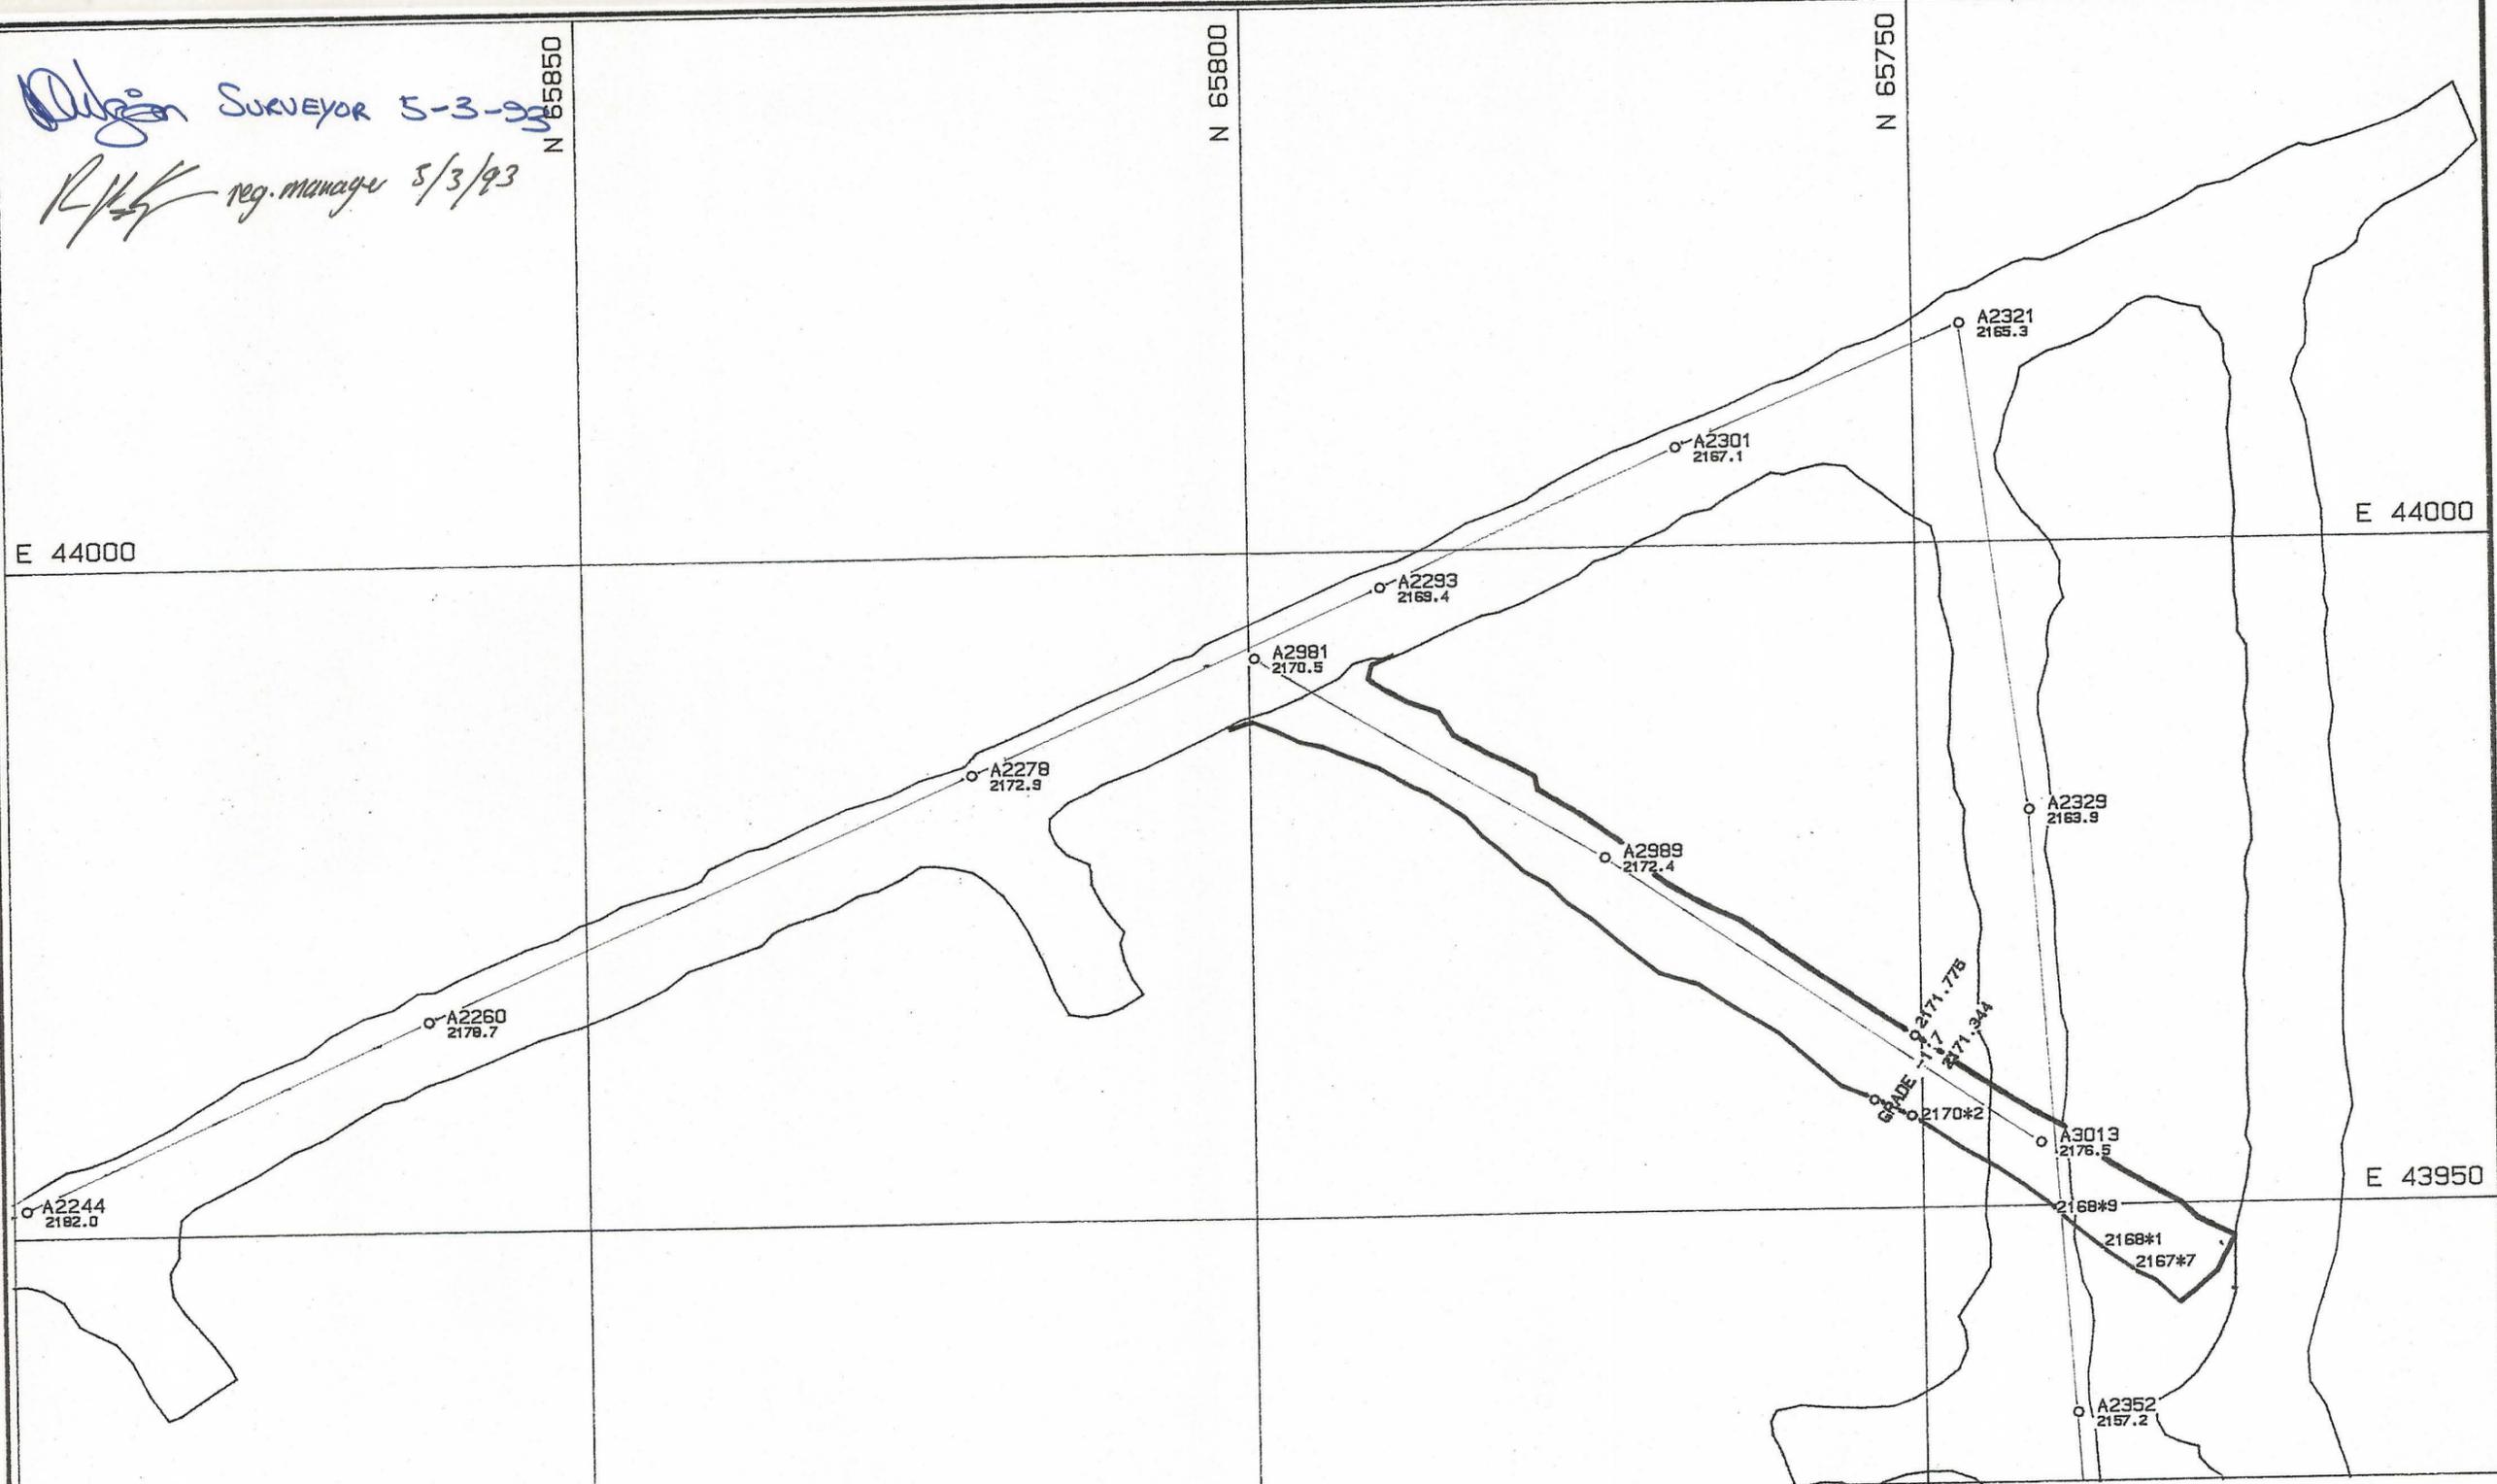

REINSON LIMITED		
PIEMAN 4 ACCESS FLOOR HEIGHTS		
WEST COAST SURVEYS PTY LTD		
Scale 1:500	Survey Ext 225	21-SEP-92

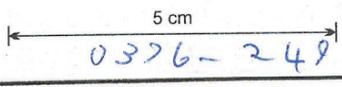

PIEMAN.PF