



0376-250

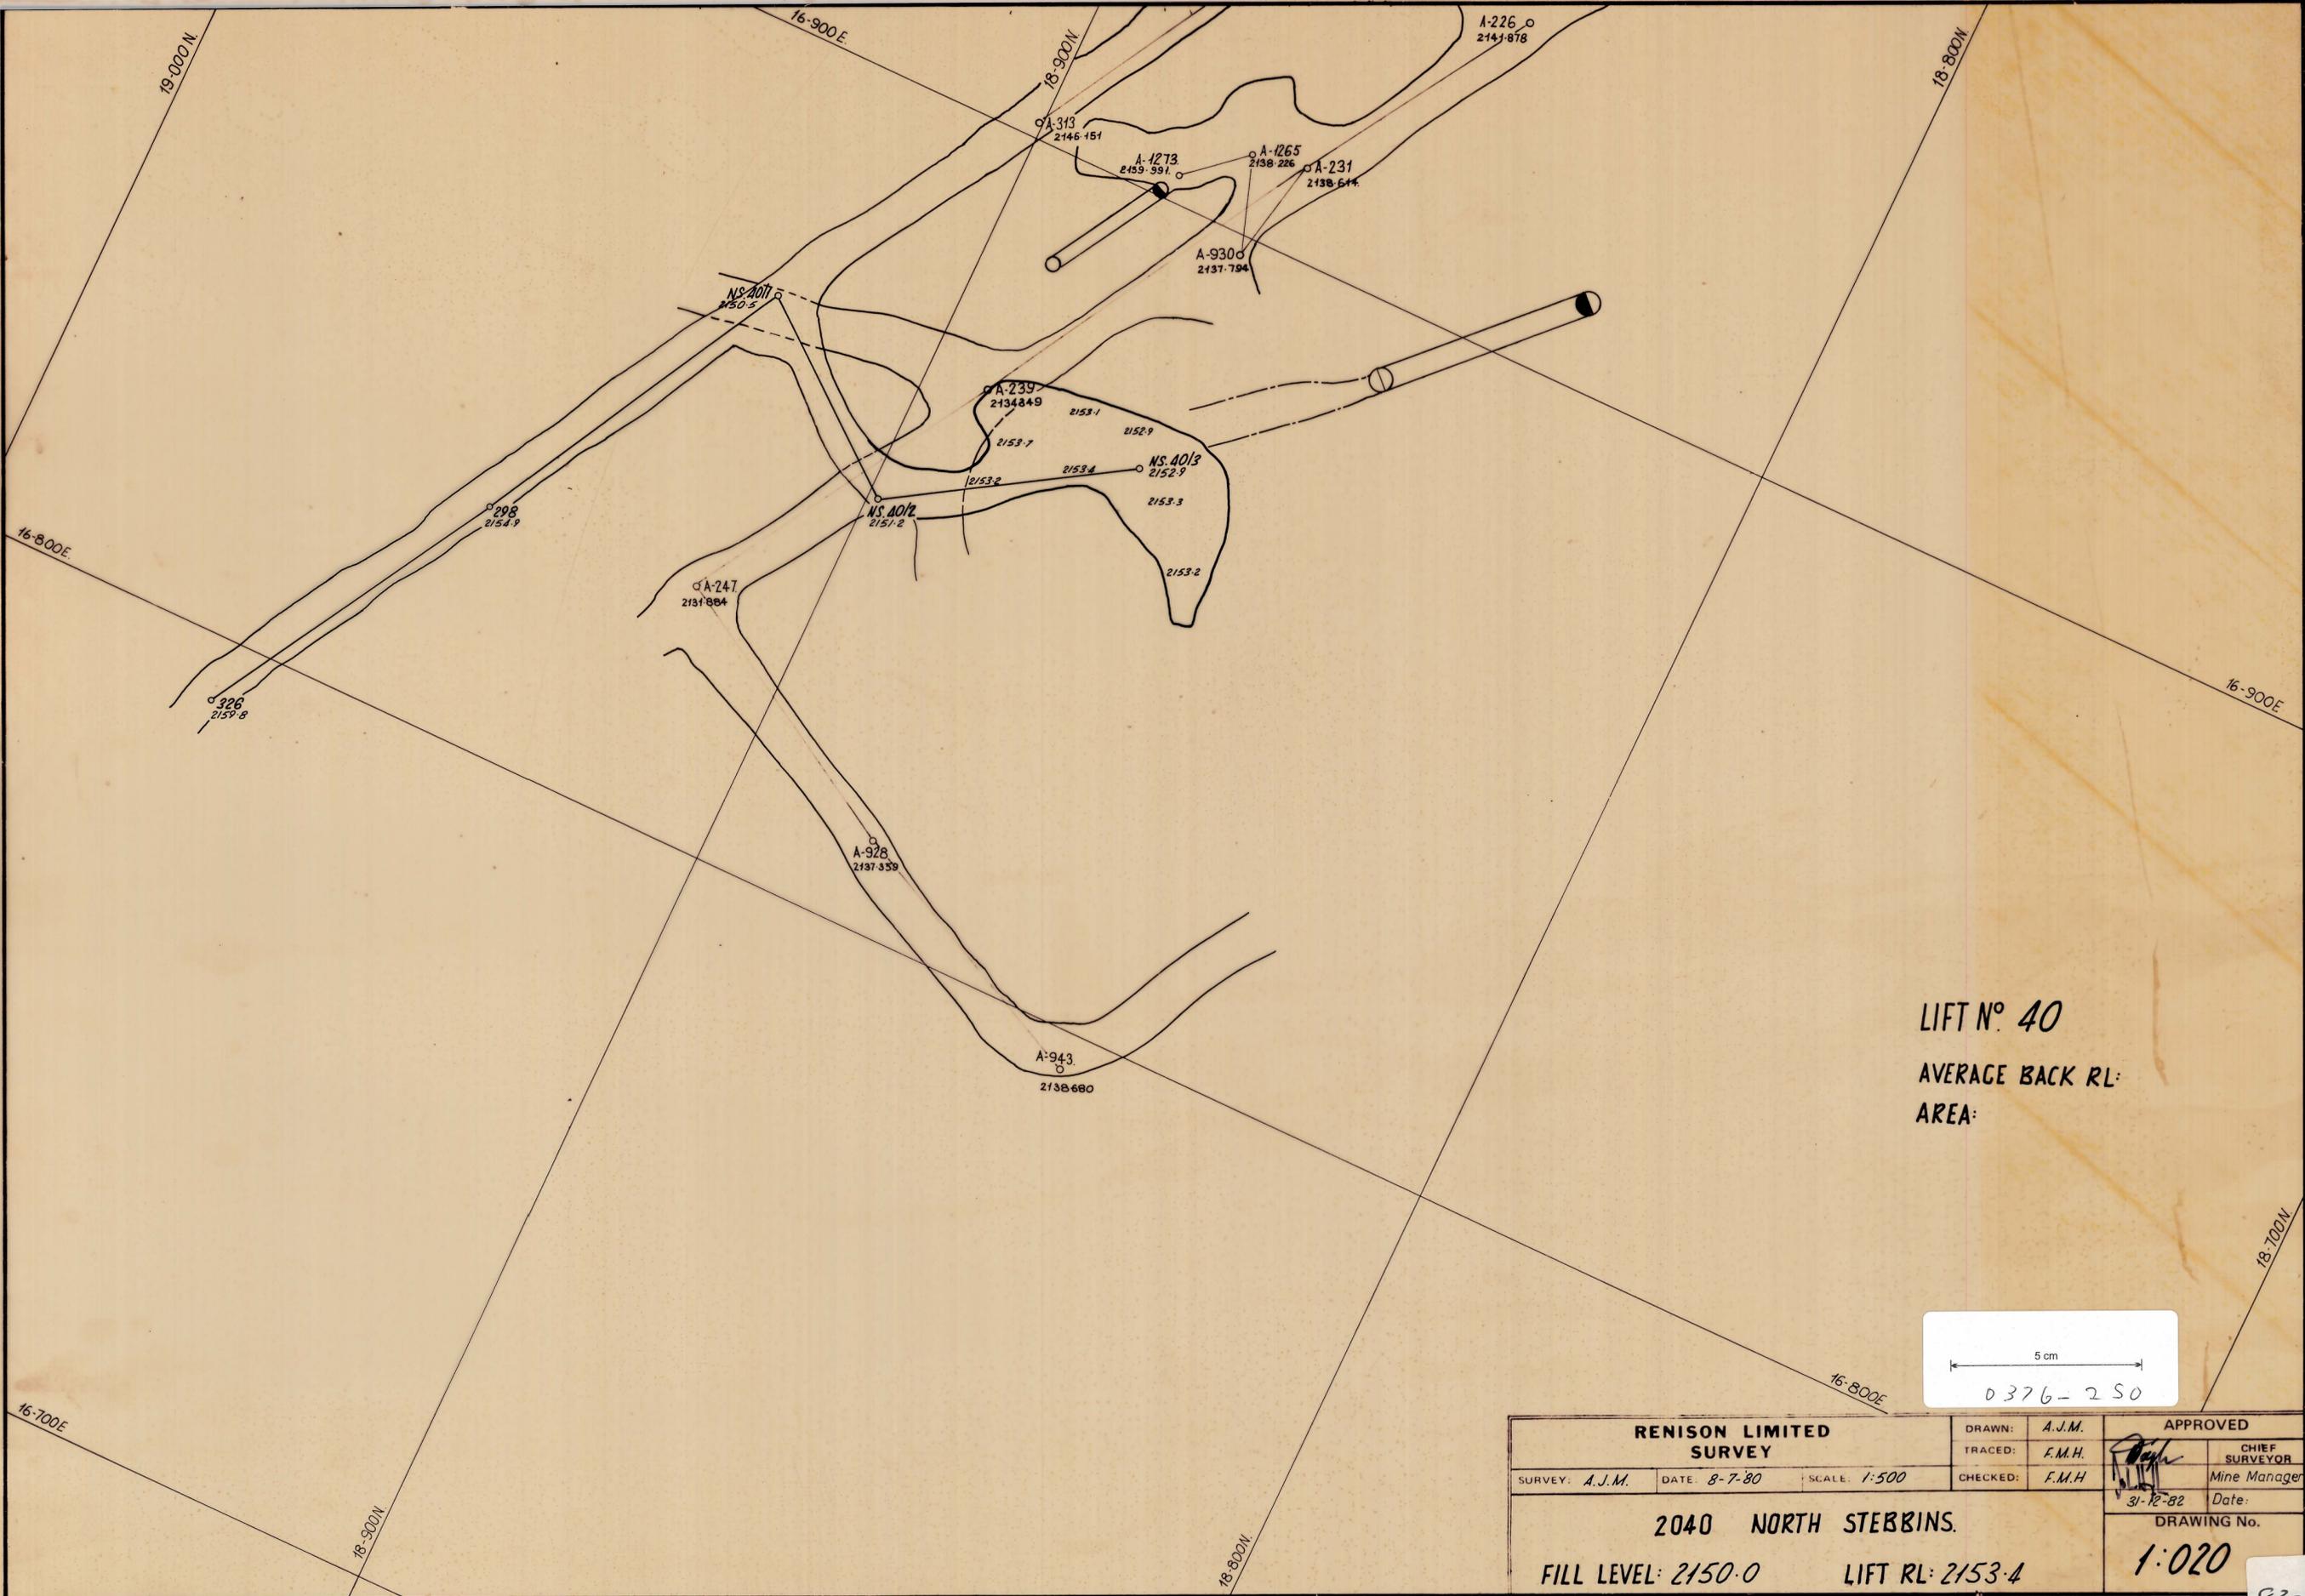

LIFT N° 40
 AVERAGE BACK RL:
 AREA:

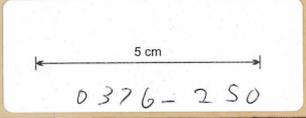

RENISON LIMITED SURVEY SURVEY: A.J.M. DATE: 8-7-80 SCALE: 1:500			DRAWN: A.J.M. TRACED: F.M.H. CHECKED: F.M.H.	APPROVED CHIEF SURVEYOR Mine Manager 31-12-82 Date:
			2040 NORTH STEBBINS. FILL LEVEL: 2150.0 LIFT RL: 2153.4	

83081