



0376-252

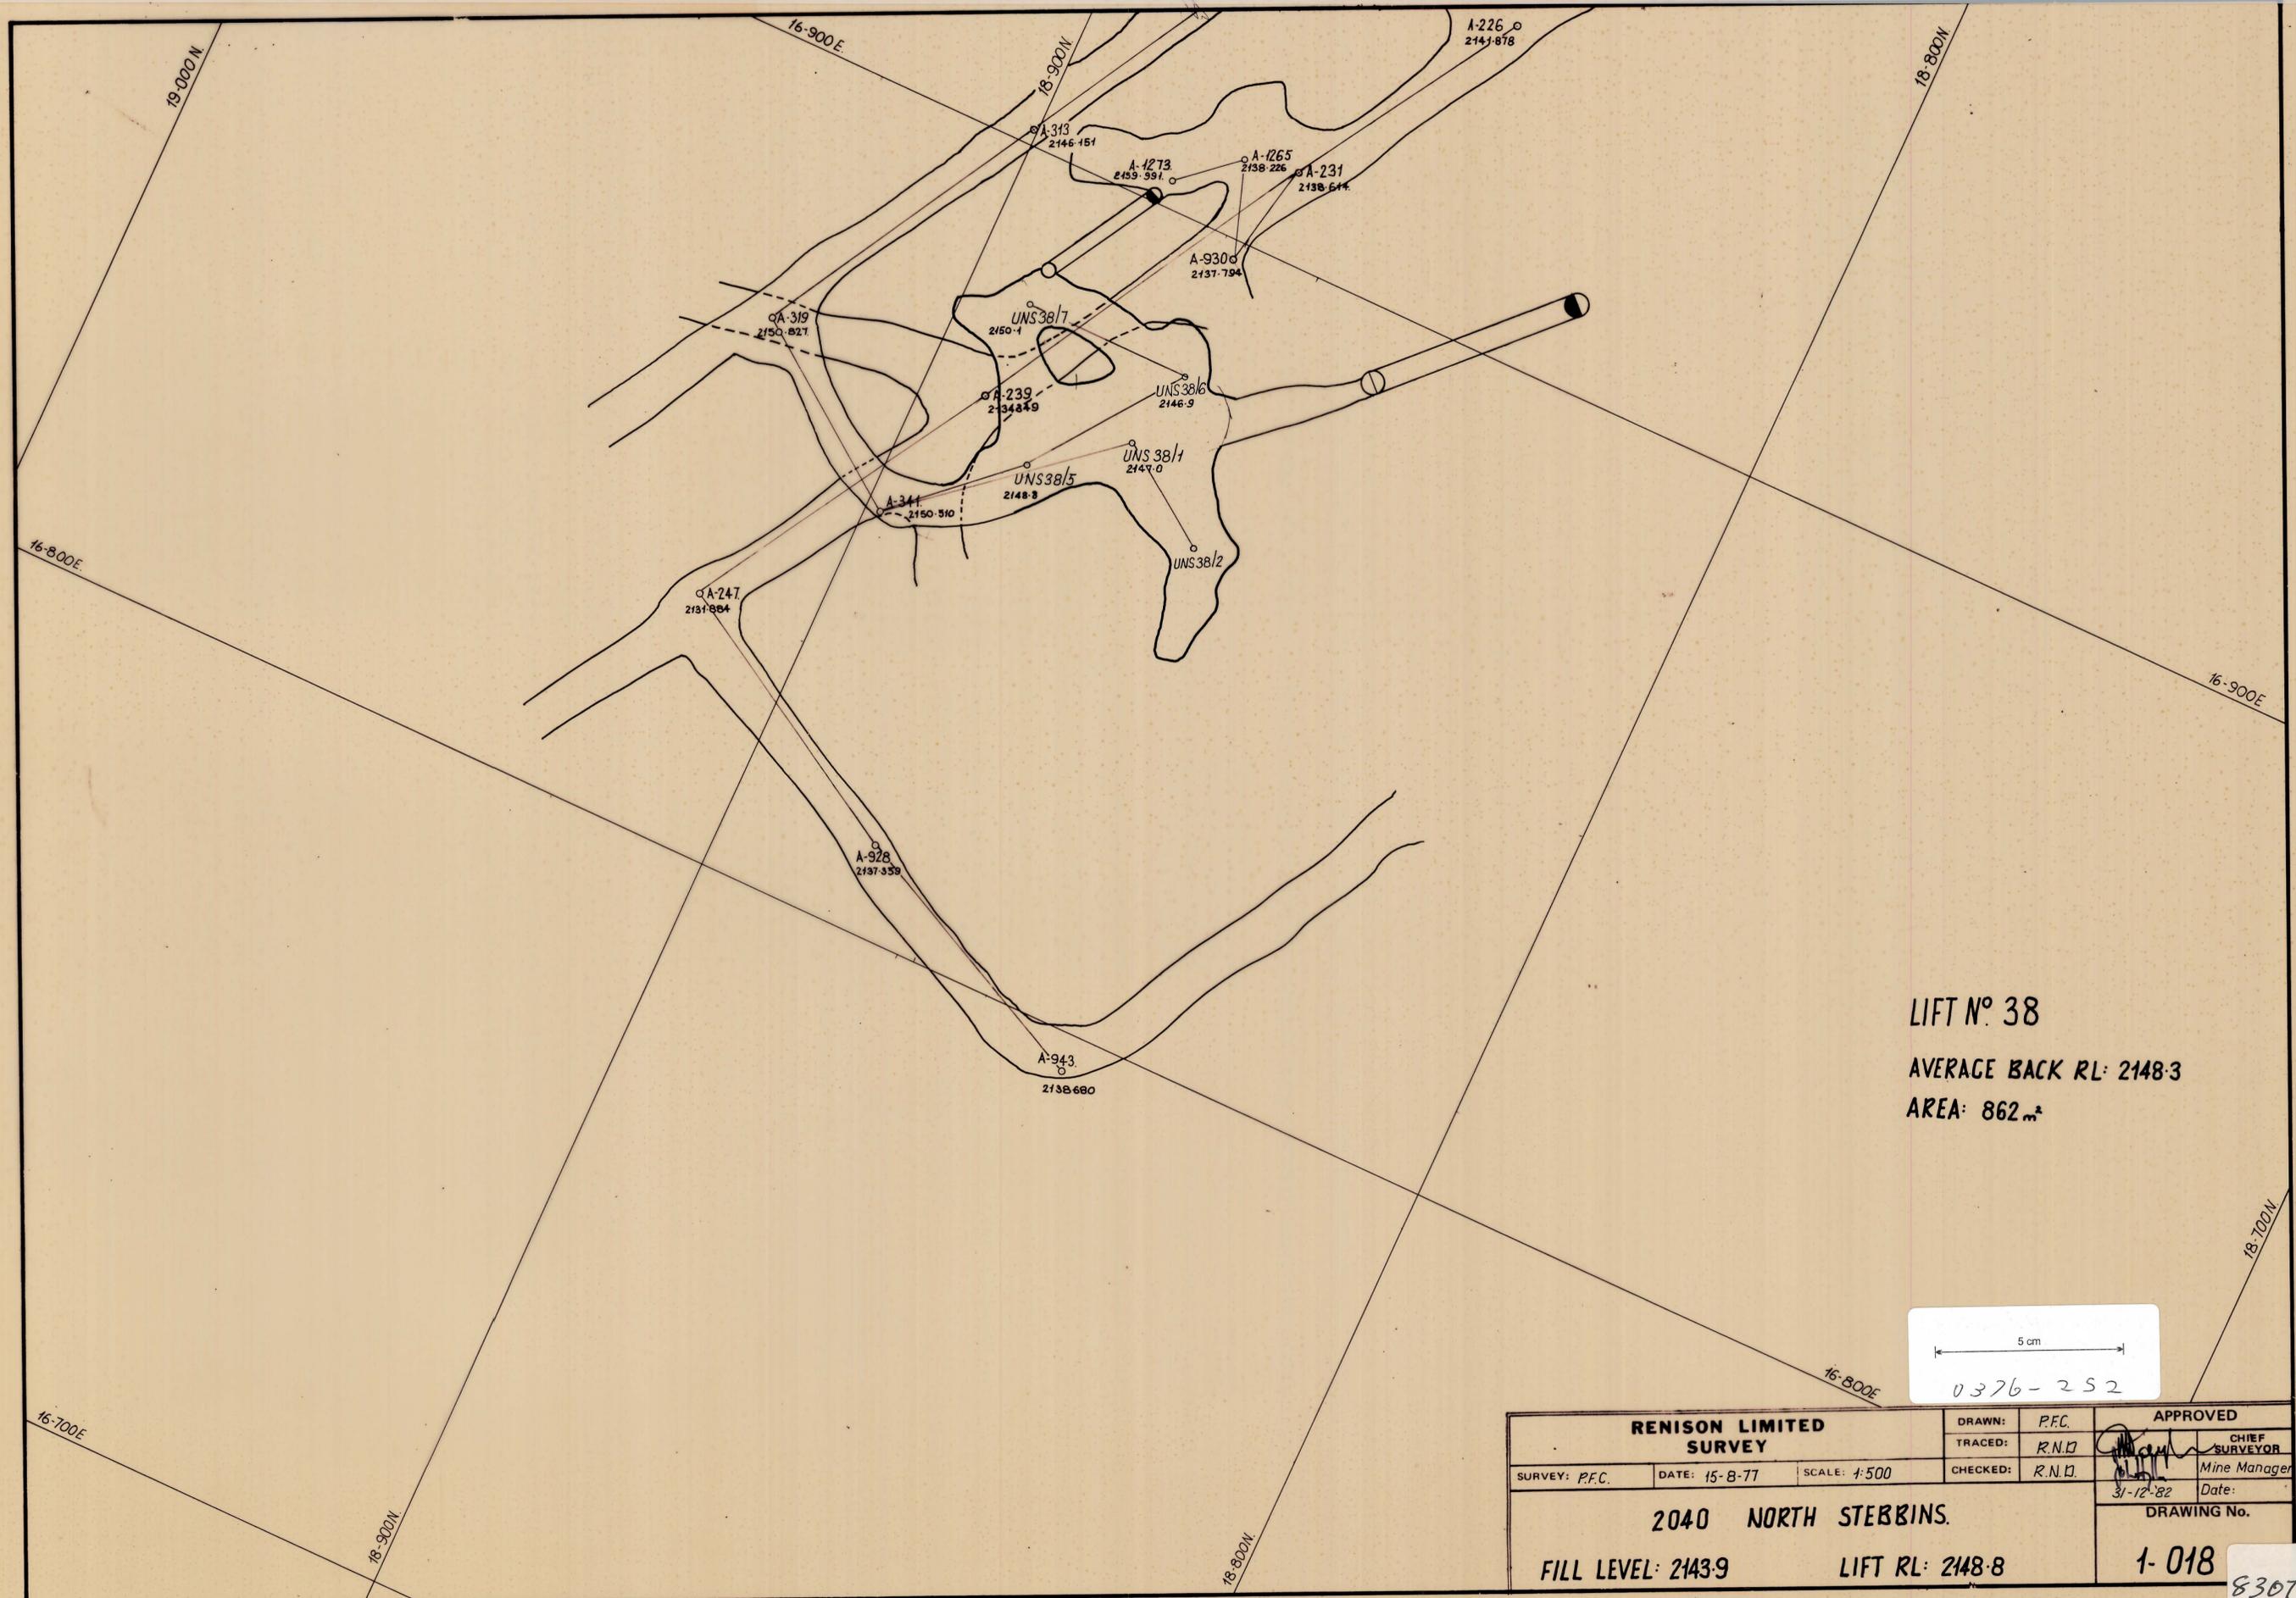

LIFT N° 38
 AVERAGE BACK RL: 2148.3
 AREA: 862 m²

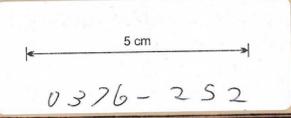

RENISON LIMITED SURVEY			DRAWN: P.F.C.	APPROVED	
			TRACED: R.N.D.	CHIEF SURVEYOR	
SURVEY: P.F.C.	DATE: 15-8-77	SCALE: 1:500	CHECKED: R.N.D.	Mine Manager	
2040 NORTH STEBBINS.				Date: 31-12-82	
FILL LEVEL: 2143.9				DRAWING No. 1-018	
LIFT RL: 2148.8				83079	