


0376 - 253

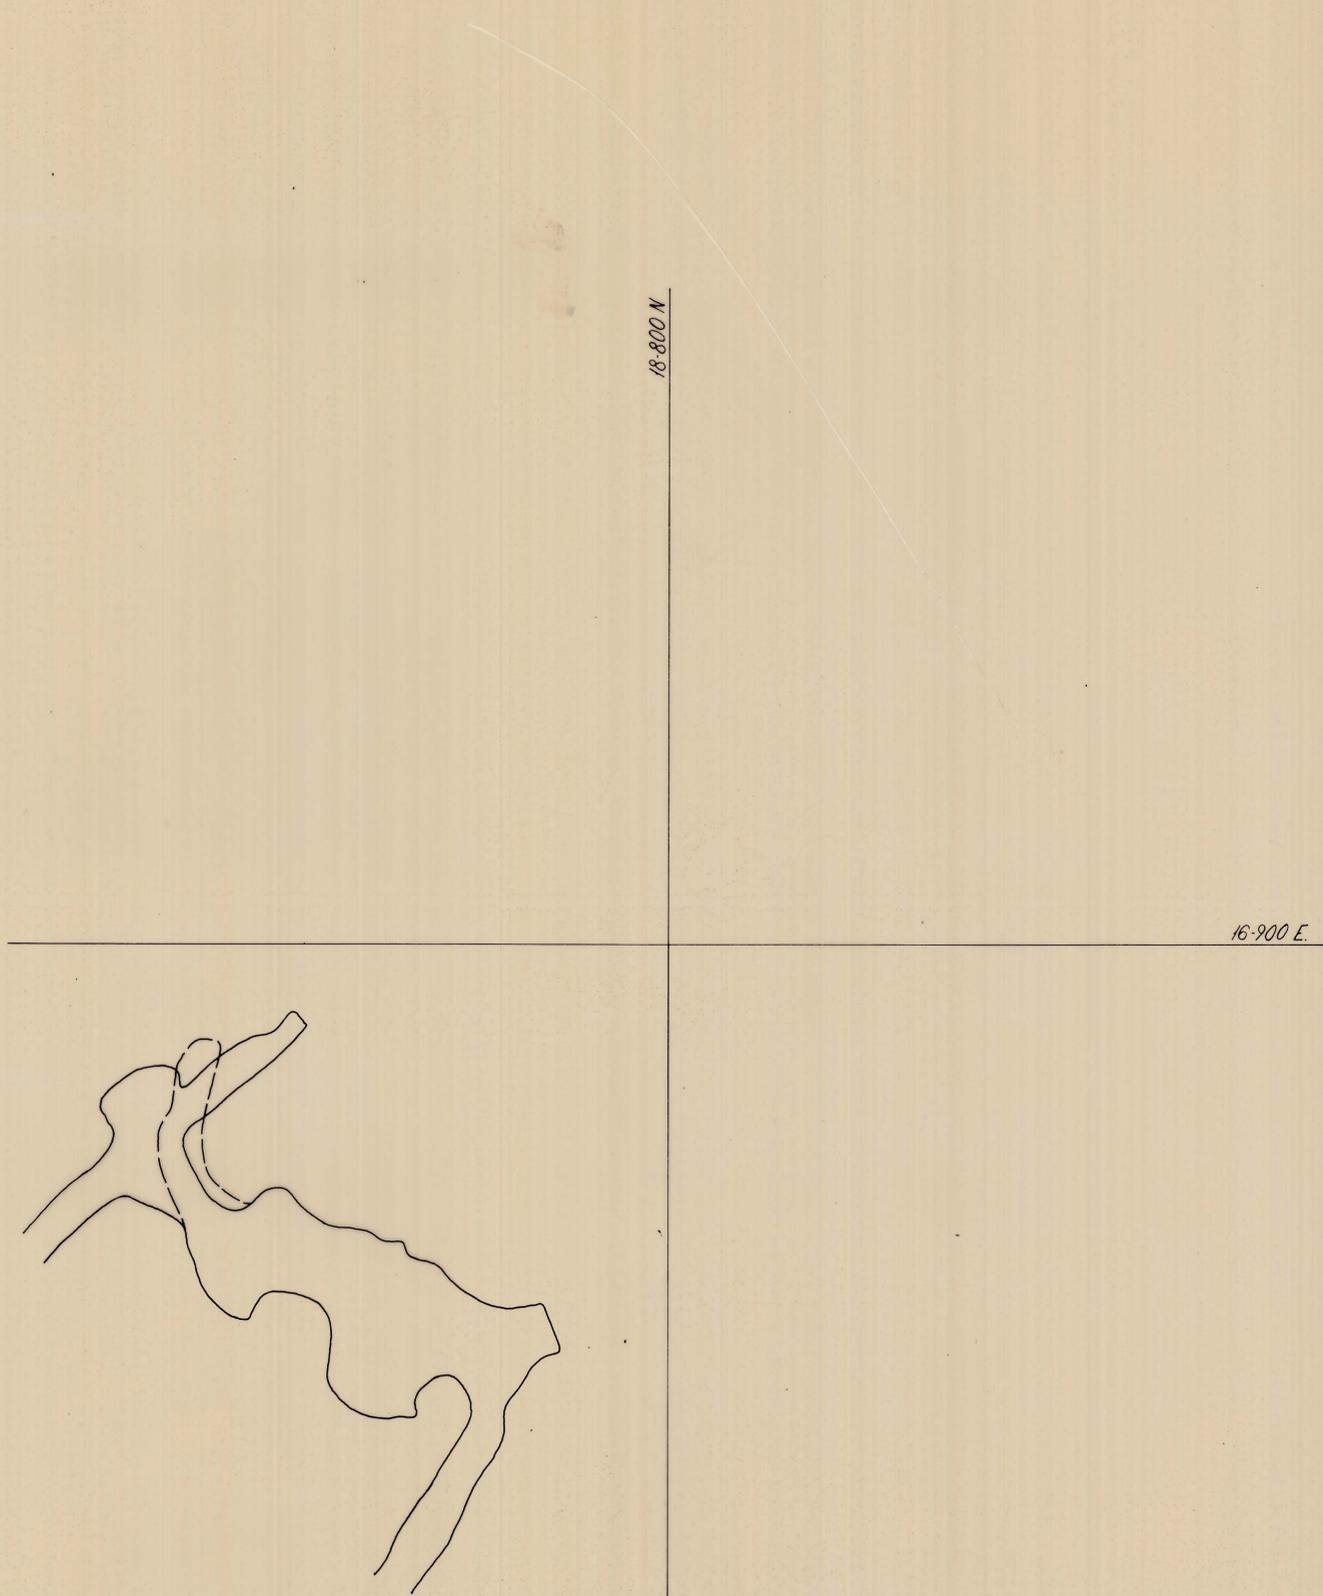

5 cm
0376 - 253

DATE	MANAGER	SURVEYOR	RENISON LIMITED SURVEY		DRAWING No.
31-12-78					22:079
31-12-82	<i>J.M.H.</i>	<i>W. [unclear]</i>	DRAWN F.M.H.	DATE 13-3-79 SCALE 1:500	
			2040 NORTH STEBBINS LEVEL: 2135 - 2143		

93078