
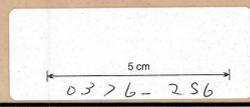


0376-256

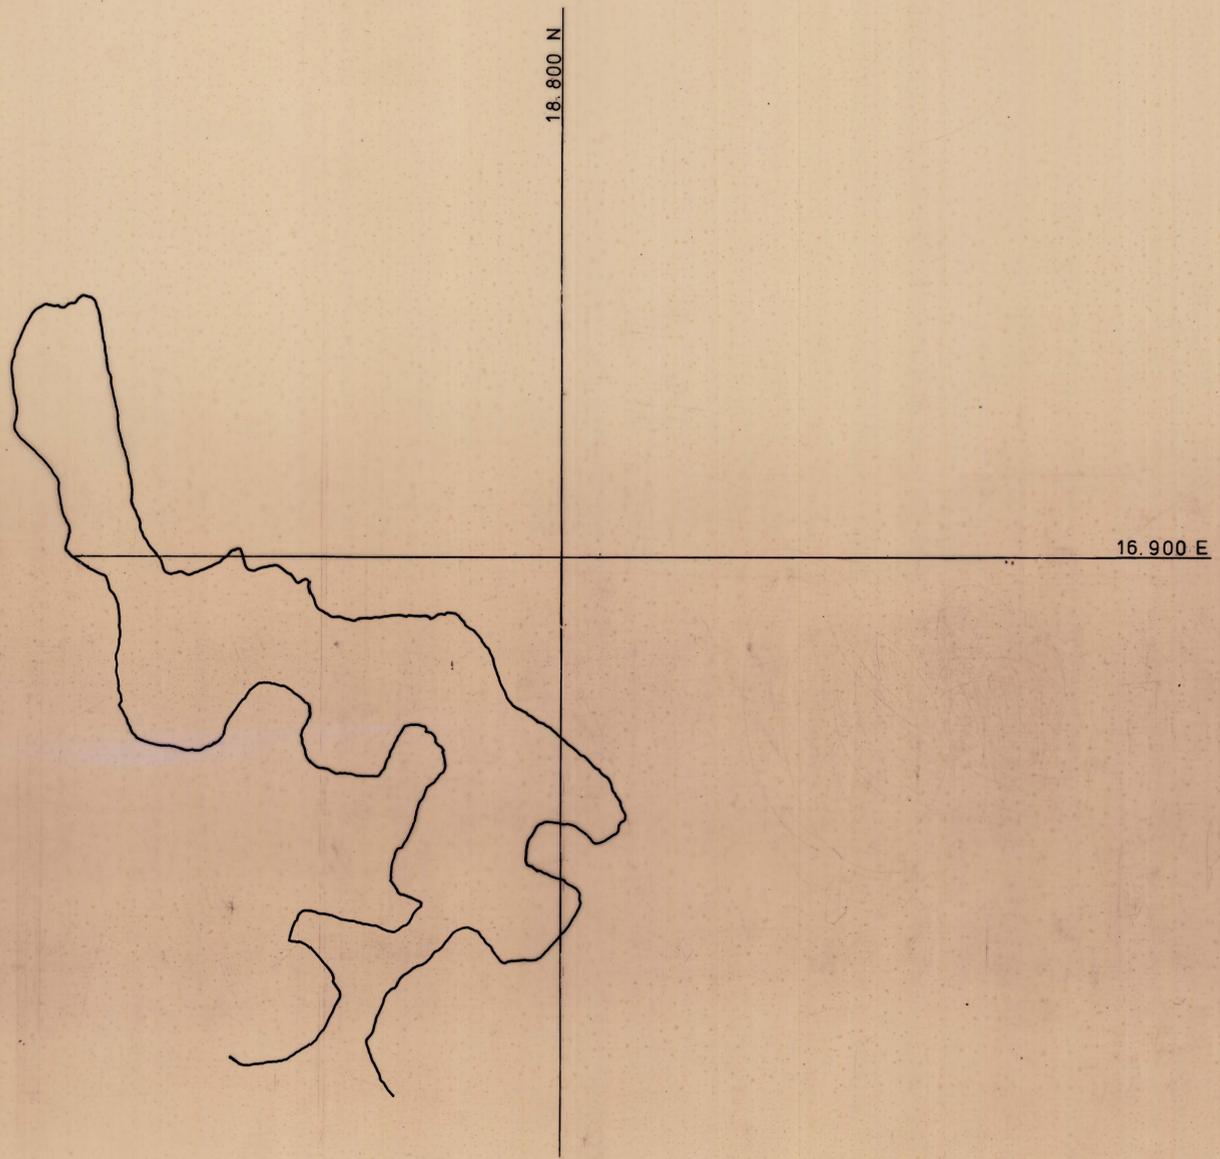

DATE	MANAGER	SURVEYOR	RENISON LIMITED SURVEY			DRAWING No.
3/12/74			DRAWN. A.J.M.	DATE. 24.4.74	SCALE. 1:500	22:079
3/12/82	<i>[Signature]</i>	<i>[Signature]</i>	UPPER NORTH STEBBINS STOPE LEVEL 2125			

83075