


0376-257

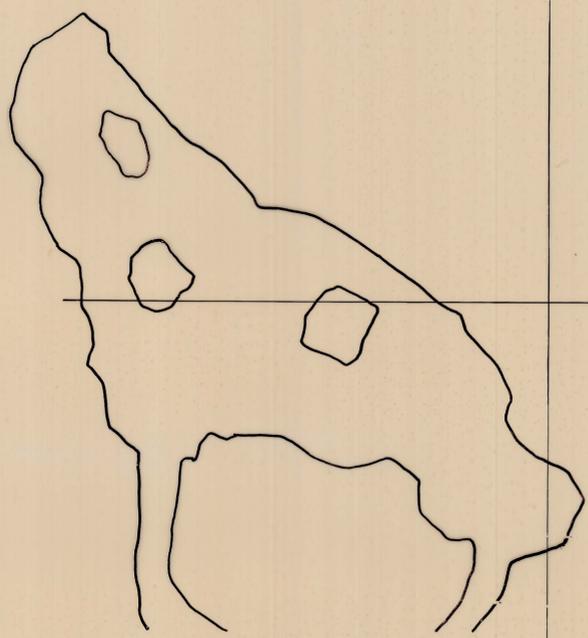

5 cm  
0376-257

DATE	MANAGER	SURVEYOR	RENISON LIMITED SURVEY		DRAWING NO
31-12-82	<i>[Signature]</i>	<i>[Signature]</i>	DRAWN: P.W.K.	DATE: 7-3-74	SCALE: 1:500
			UPPER NORTH STEBBINS STOPE		22-079
			LEVEL: 2120.00		

83074