



0376-258

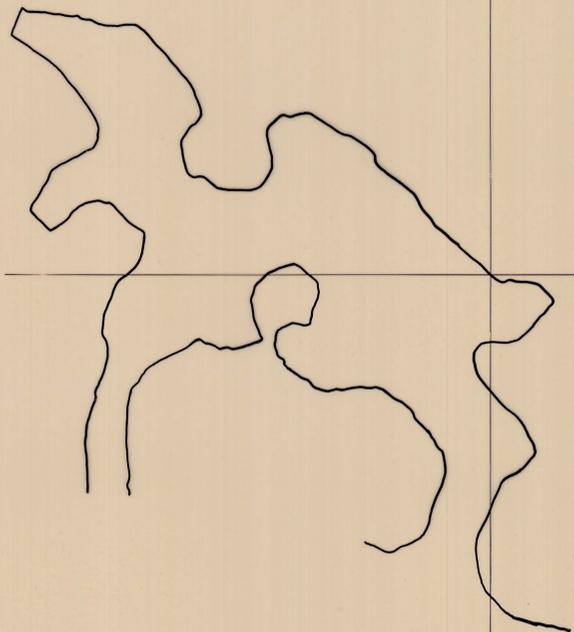

16,800.N.

16,300.E.

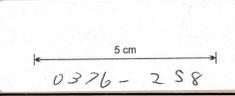

DATE	MANAGER	SURVEYOR	RENISON LIMITED SURVEY			DRAWING NO
31-12-82	<i>[Signature]</i>	<i>[Signature]</i>				22.079
			DRAWN: P.W.K.	DATE: 26.2.73	SCALE: 1:500	
			UPPER NORTH STEBBINS STOPE			
			LEVEL: 2115.00			

83073