
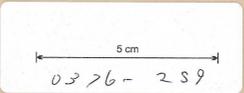


0376-259

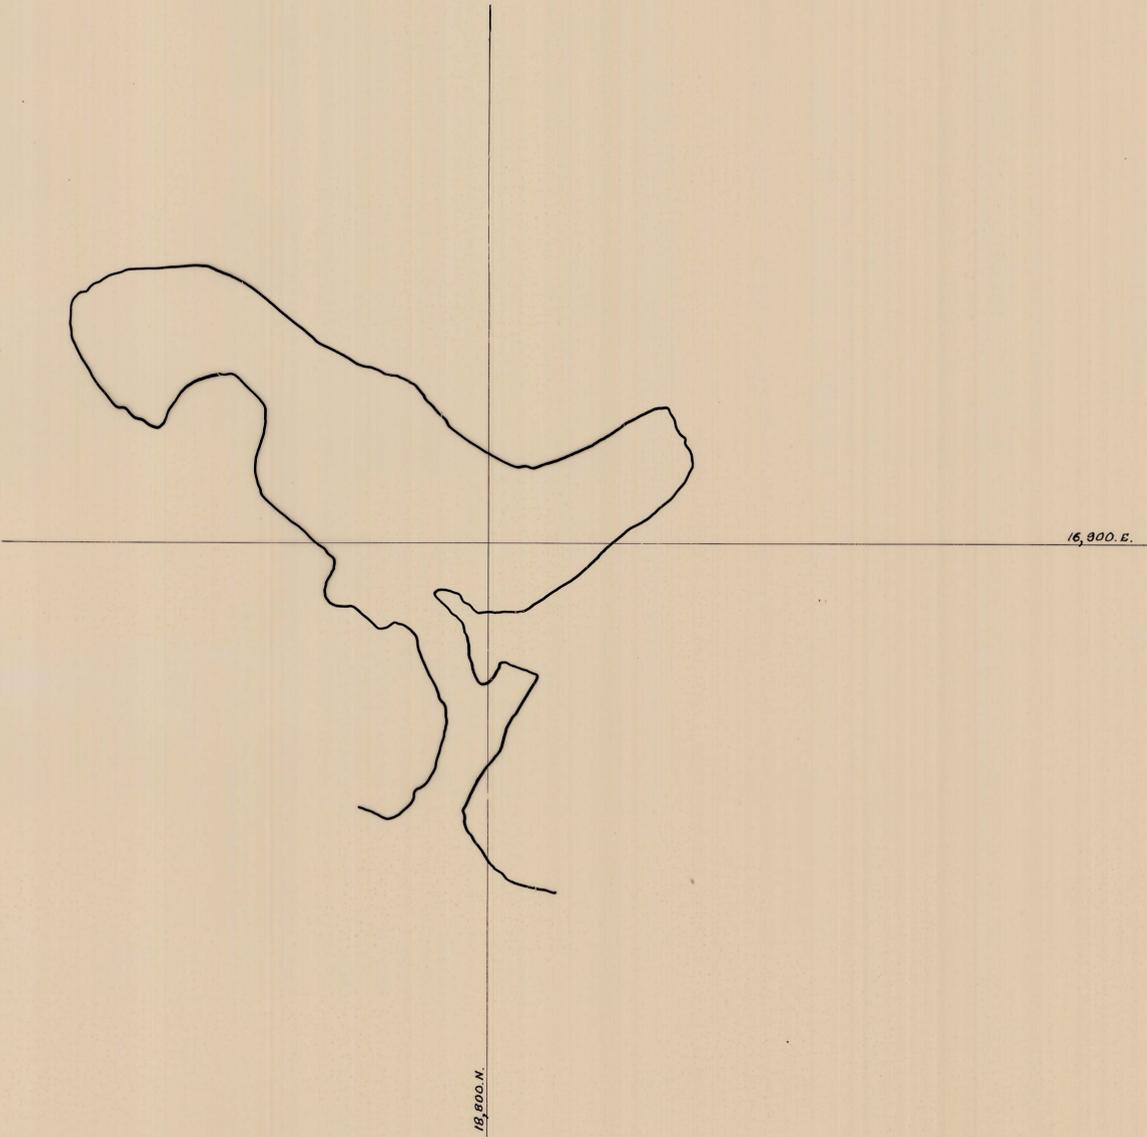

DATE	MANAGER	SURVEYOR	RENISON LIMITED SURVEY		DRAWING N <sup>o</sup>
31-12-82	<i>[Signature]</i>	<i>[Signature]</i>	DRAWN: P.W.K.	DATE: 26-2-73	SCALE: 1:500
			UPPER NORTH STEBBINS STOPE		22:079
			LEVEL: 2110.00		

83072