


0376-260

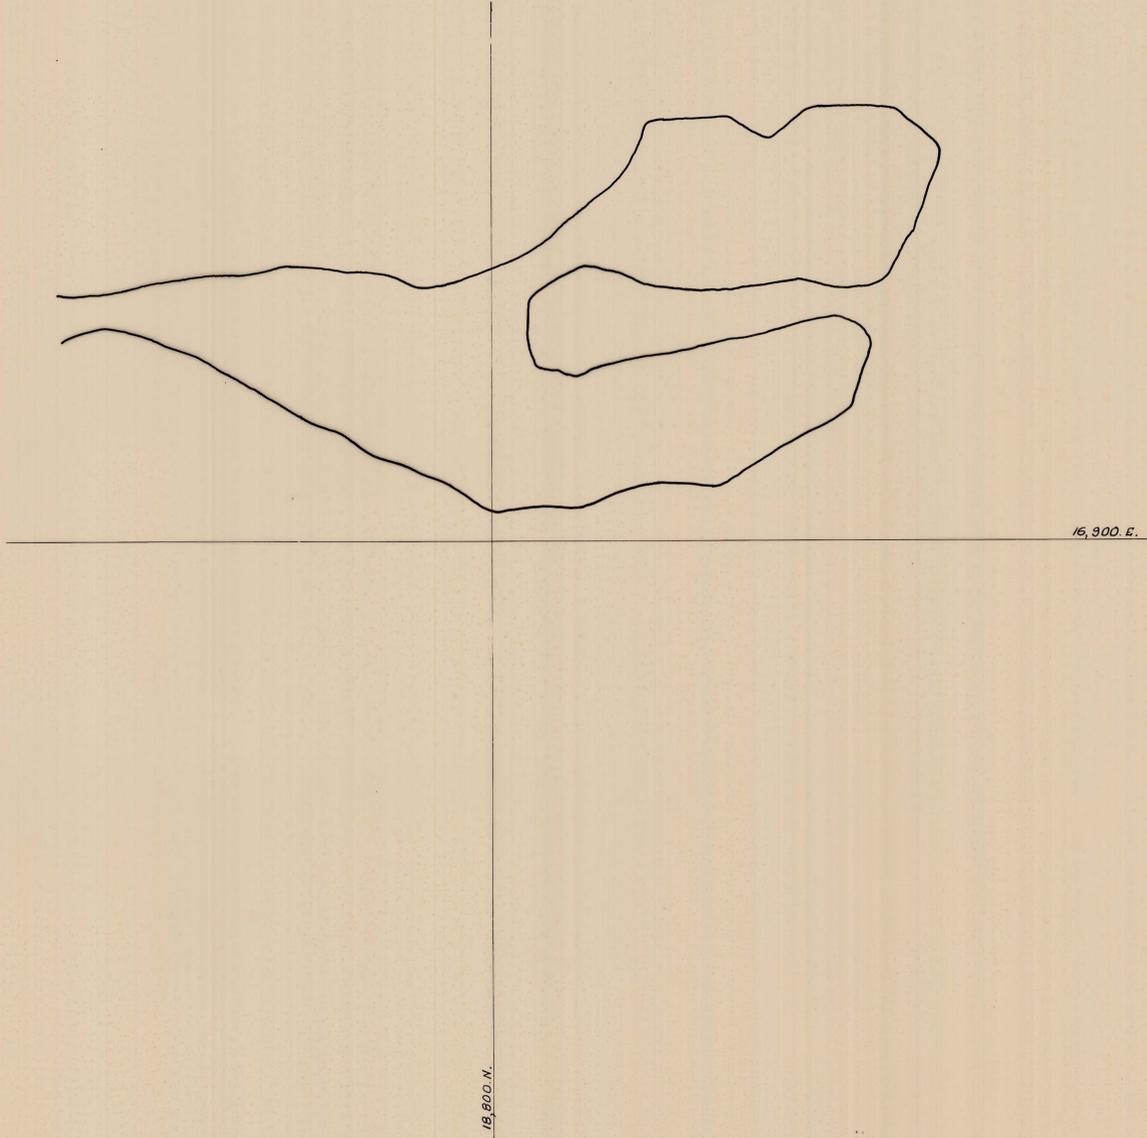

5 cm
0376-260

DATE	MANAGER	SURVEYOR	RENISON LIMITED SURVEY			DRAWING N°
31-12-82	<i>[Signature]</i>	<i>[Signature]</i>	DRAWN: P.W.K.	DATE: 26.2.73	SCALE: 1:500	22:079
			UPPER NORTH STEBBINS STONE LEVEL: 2100.00			

83071