


0376-261

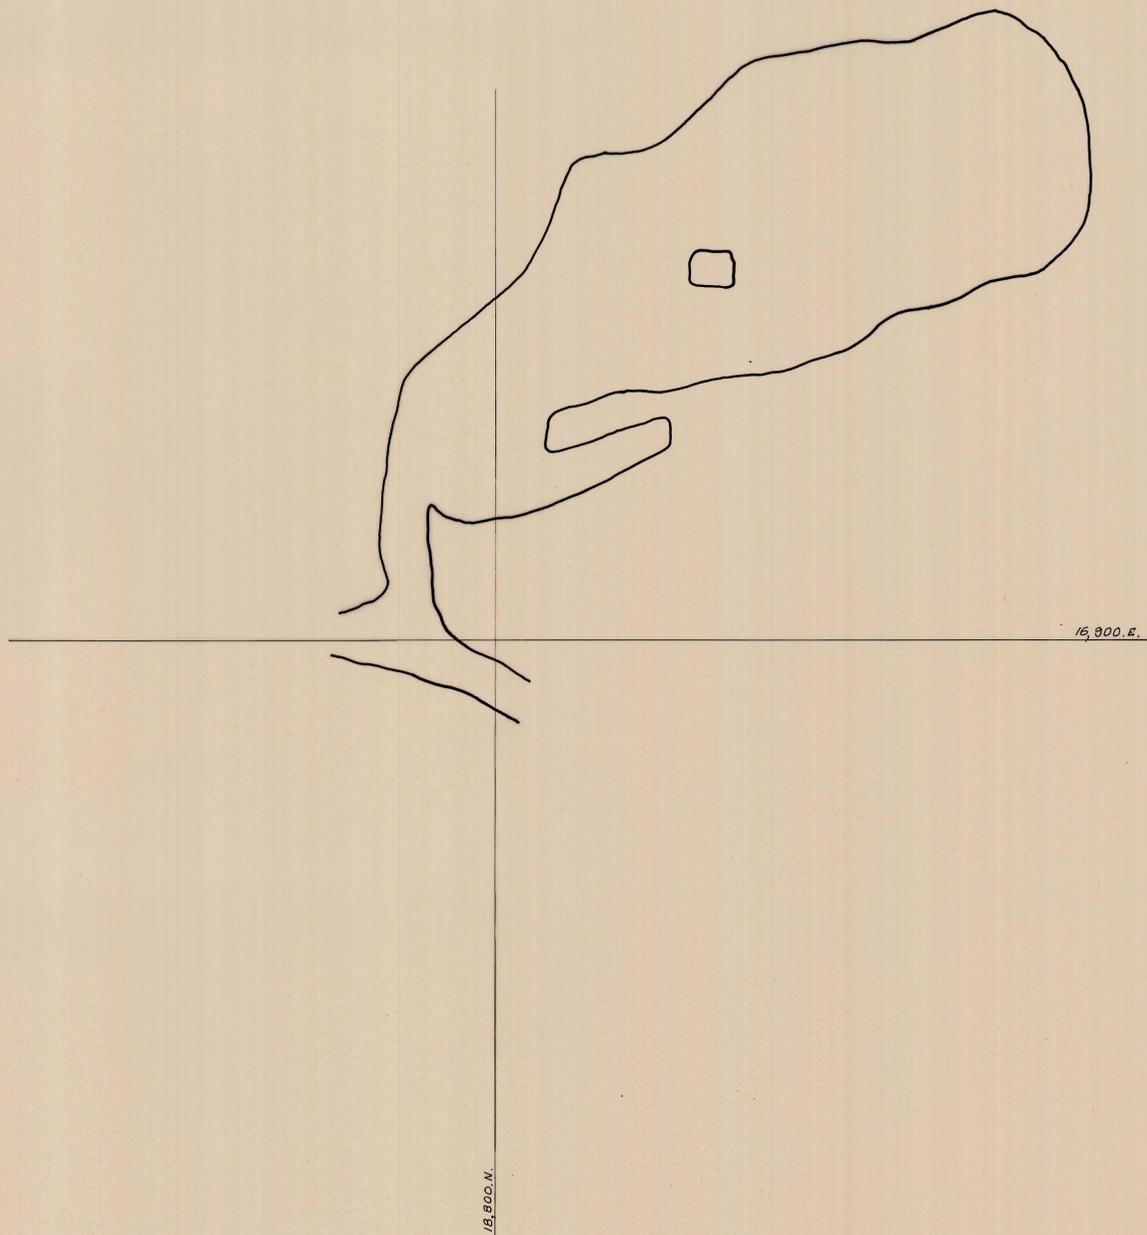

5 cm  
0376-261

DATE	MANAGER	SURVEYOR	RENISON LIMITED SURVEY		DRAWING N°
31-12-82	<i>[Signature]</i>	<i>[Signature]</i>	DRAWN: P.W.K.	DATE: 26-2-73	SCALE: 1:500
			UPPER NORTH STEBBINS STOPE		22:079
			LEVEL: 2090.00		

83070