


0376-263

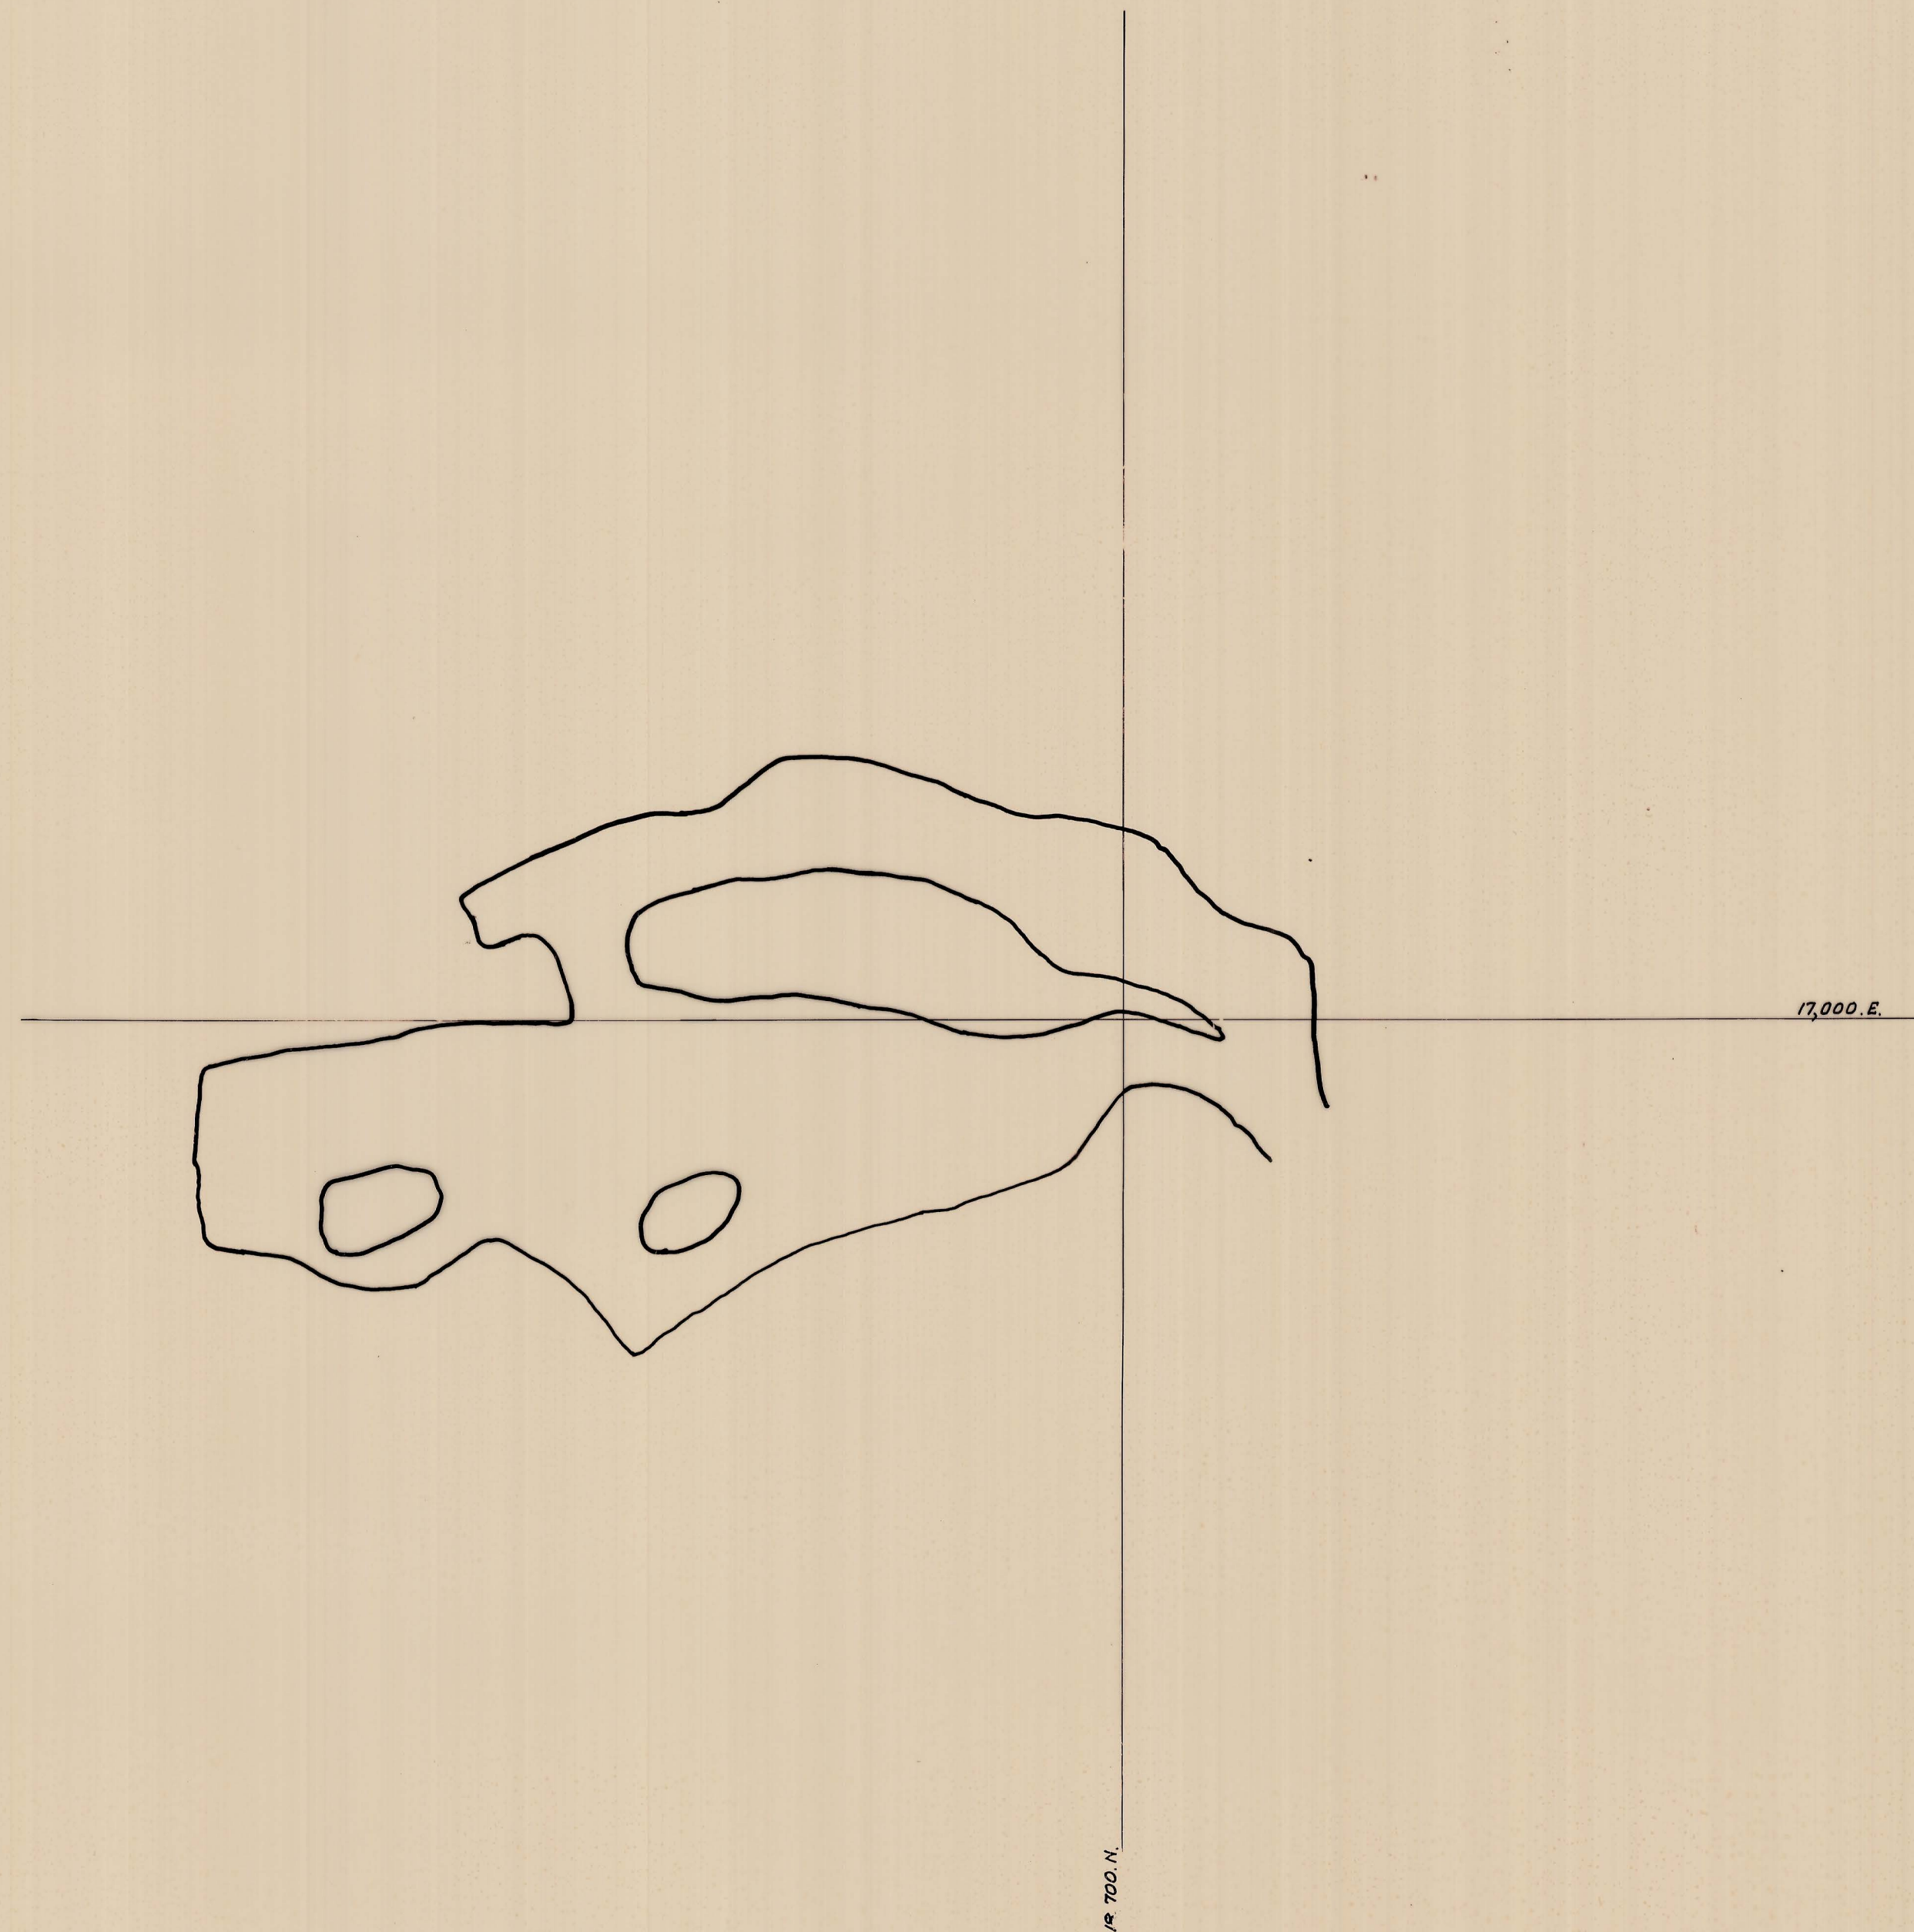

5 cm
0376-263

DATE 31-12-82	MANAGER <i>[Signature]</i>	SURVEYOR <i>[Signature]</i>	RENISON LIMITED SURVEY		DRAWING N° 22:079
			DRAWN : P.W.K.	DATE : 23-2-73	
			UPPER NORTH STEBBINS STOPE LEVEL : 2070.00		

83068