


0376-264

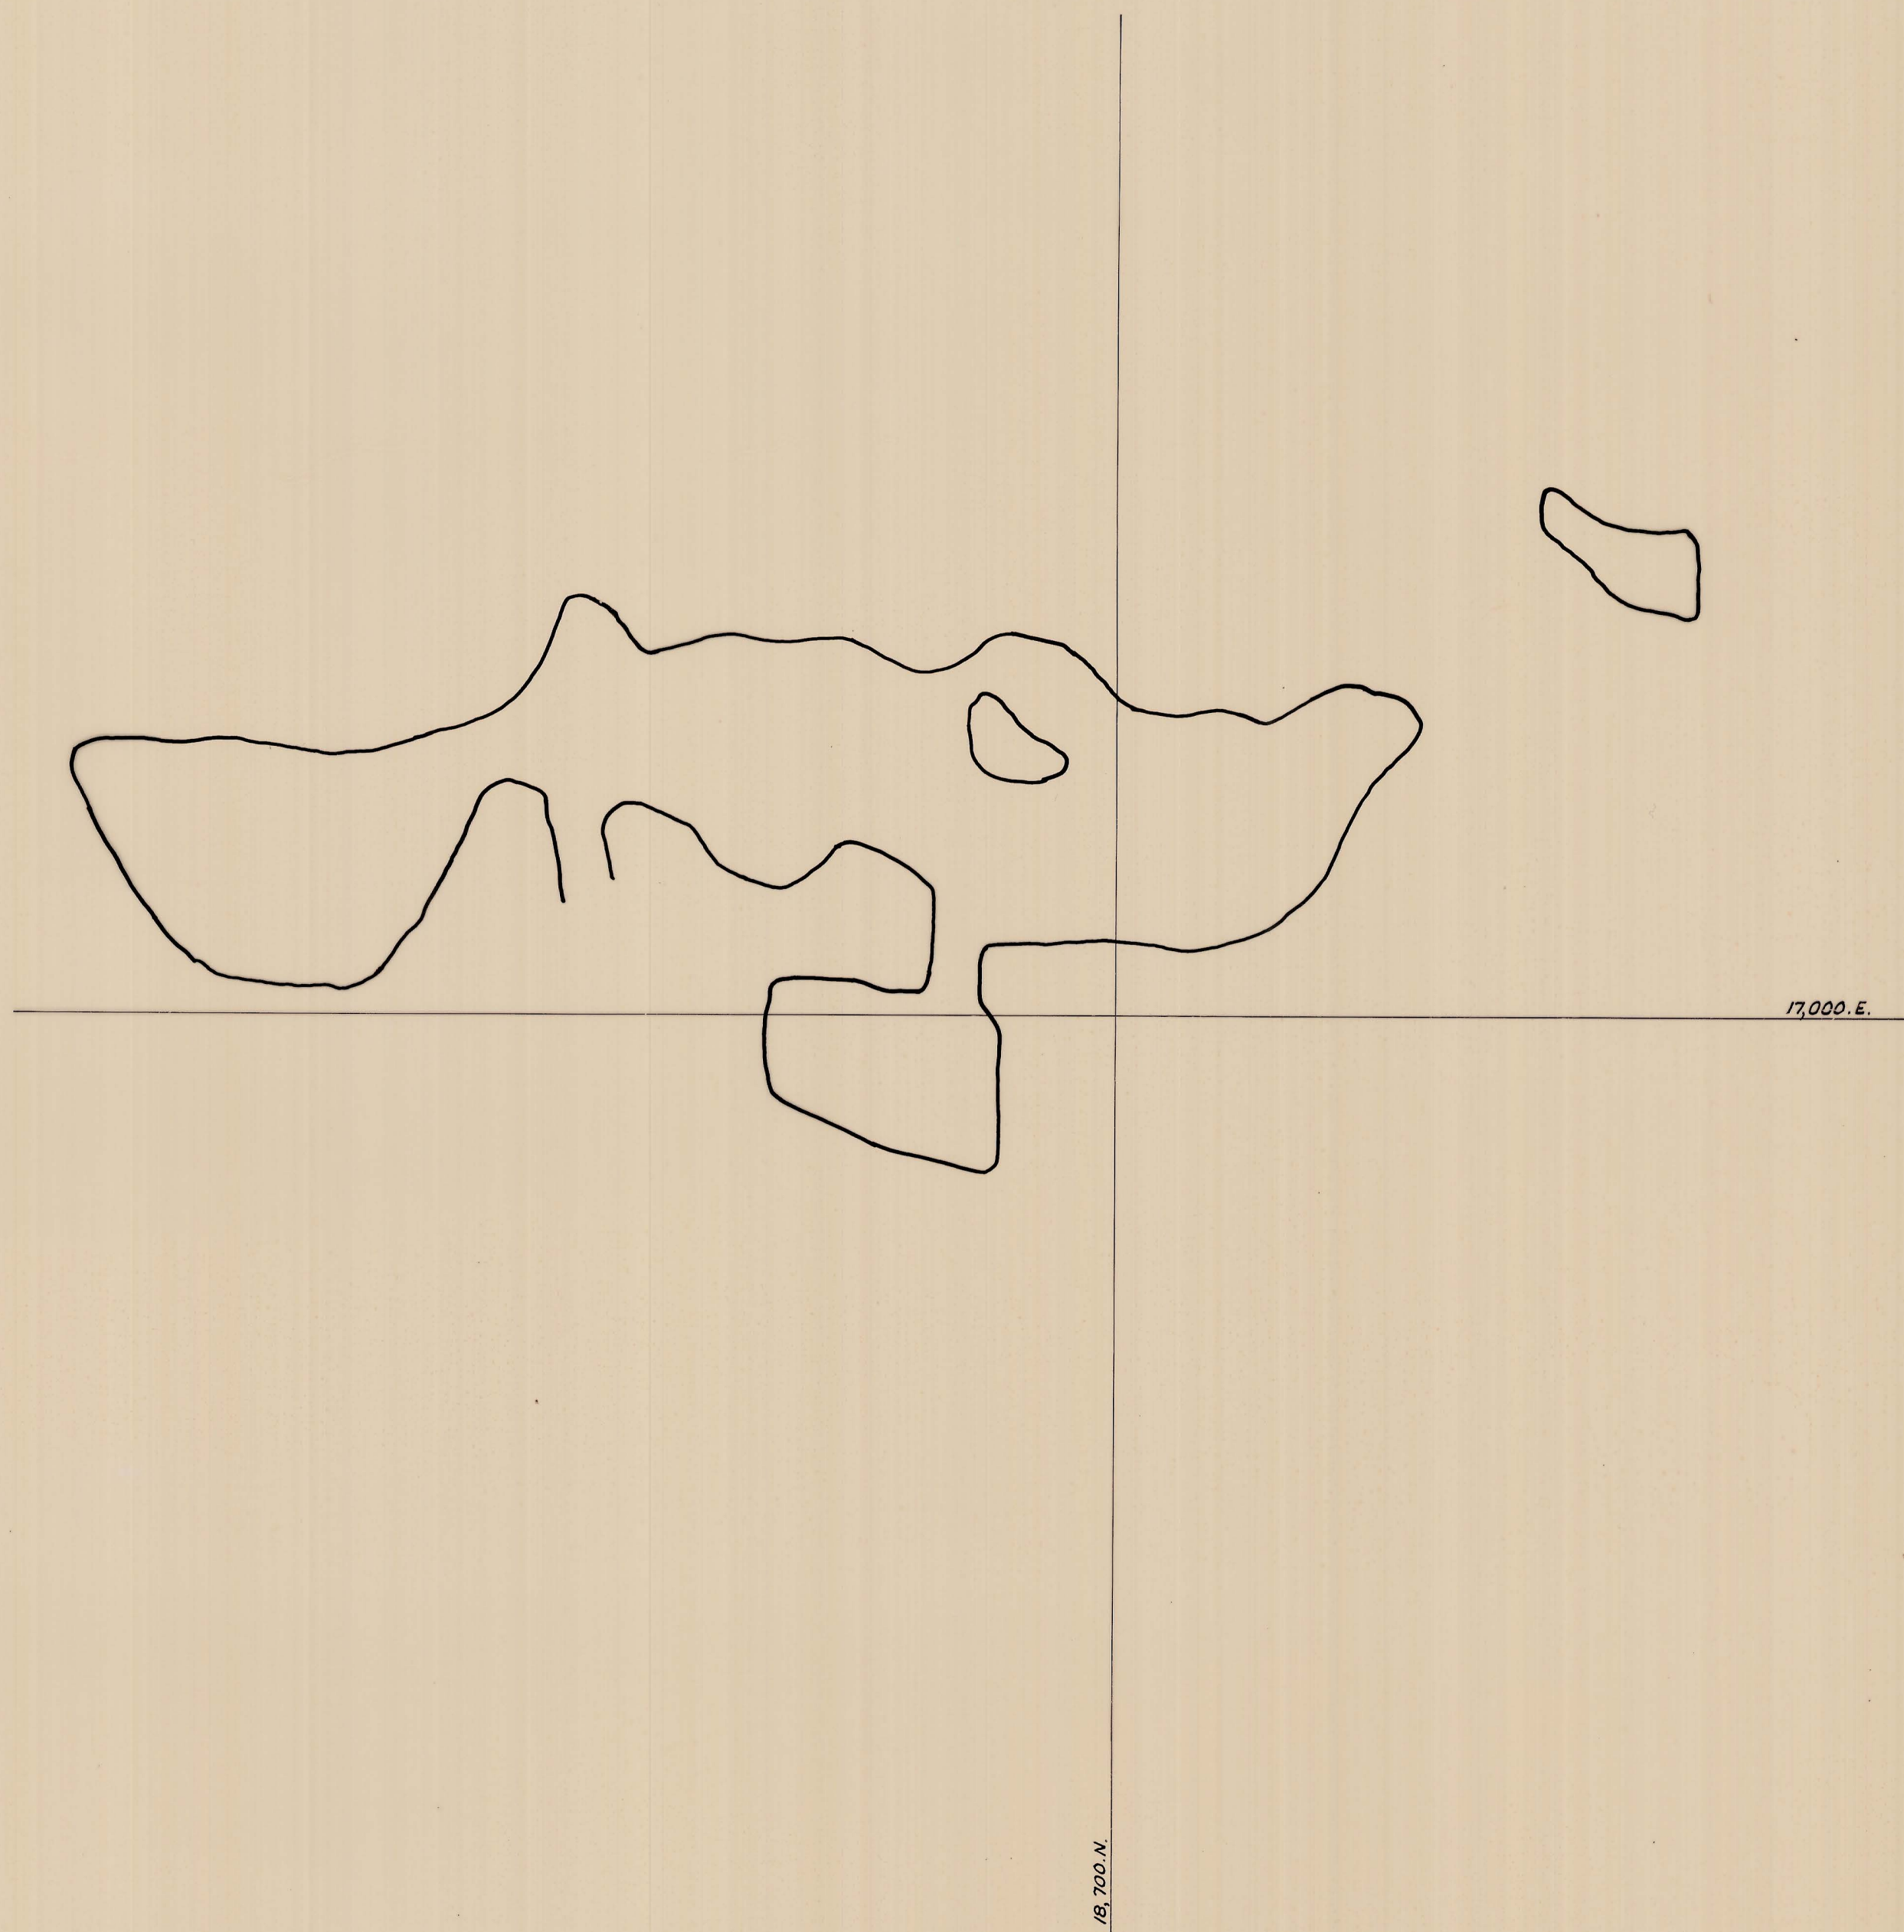

5 cm

0376-264

DATE	MANAGER	SURVEYOR	RENISON LIMITED SURVEY		DRAWING NO
31-12-82	<i>[Signature]</i>	<i>[Signature]</i>			22:079
			DRAWN: P.W.K.	DATE: 23-2-73	
			SCALE: 1:500		
			UPPER NORTH STEBBINS STOPE LEVEL: 2060.00		

83067