


0376-265

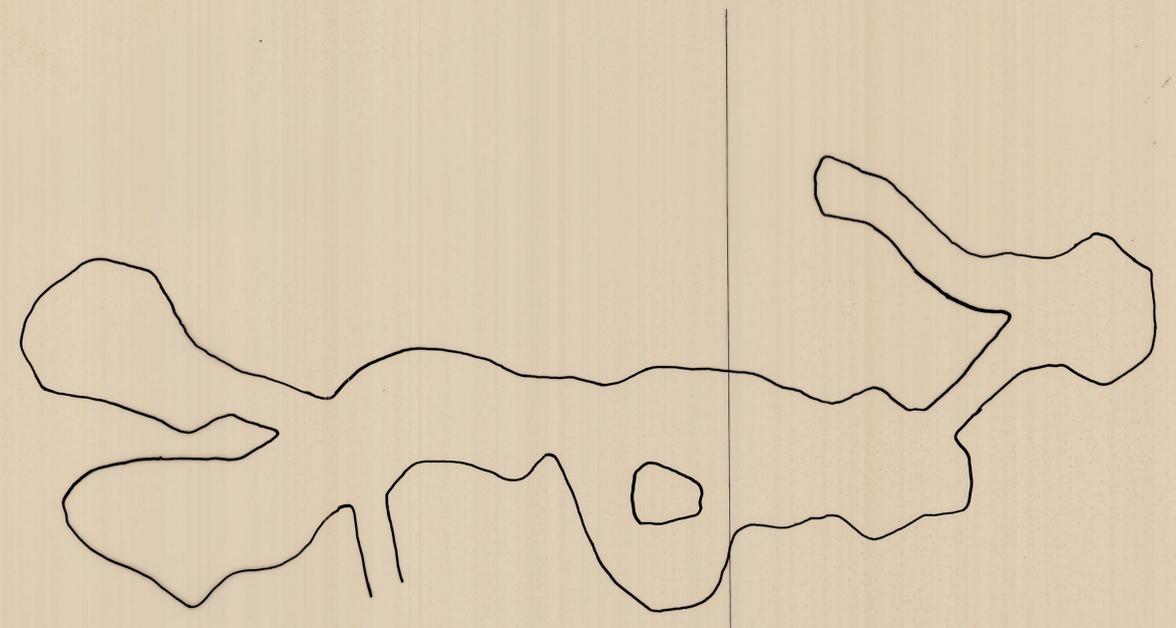

17,000 E.

18,700 N.

5 cm

0376-265

DATE	MANAGER	SURVEYOR	RENISON LIMITED SURVEY			DRAWING N <sup>o</sup>
31-12-82	<i>[Signature]</i>	<i>[Signature]</i>				22-079
			DRAWN: P.W.K.	DATE: 23-2-77	SCALE: 1:500	
			UPPER NORTH STEBBINS STOPE			
			LEVEL: 2050.00			

83066