



0376-269

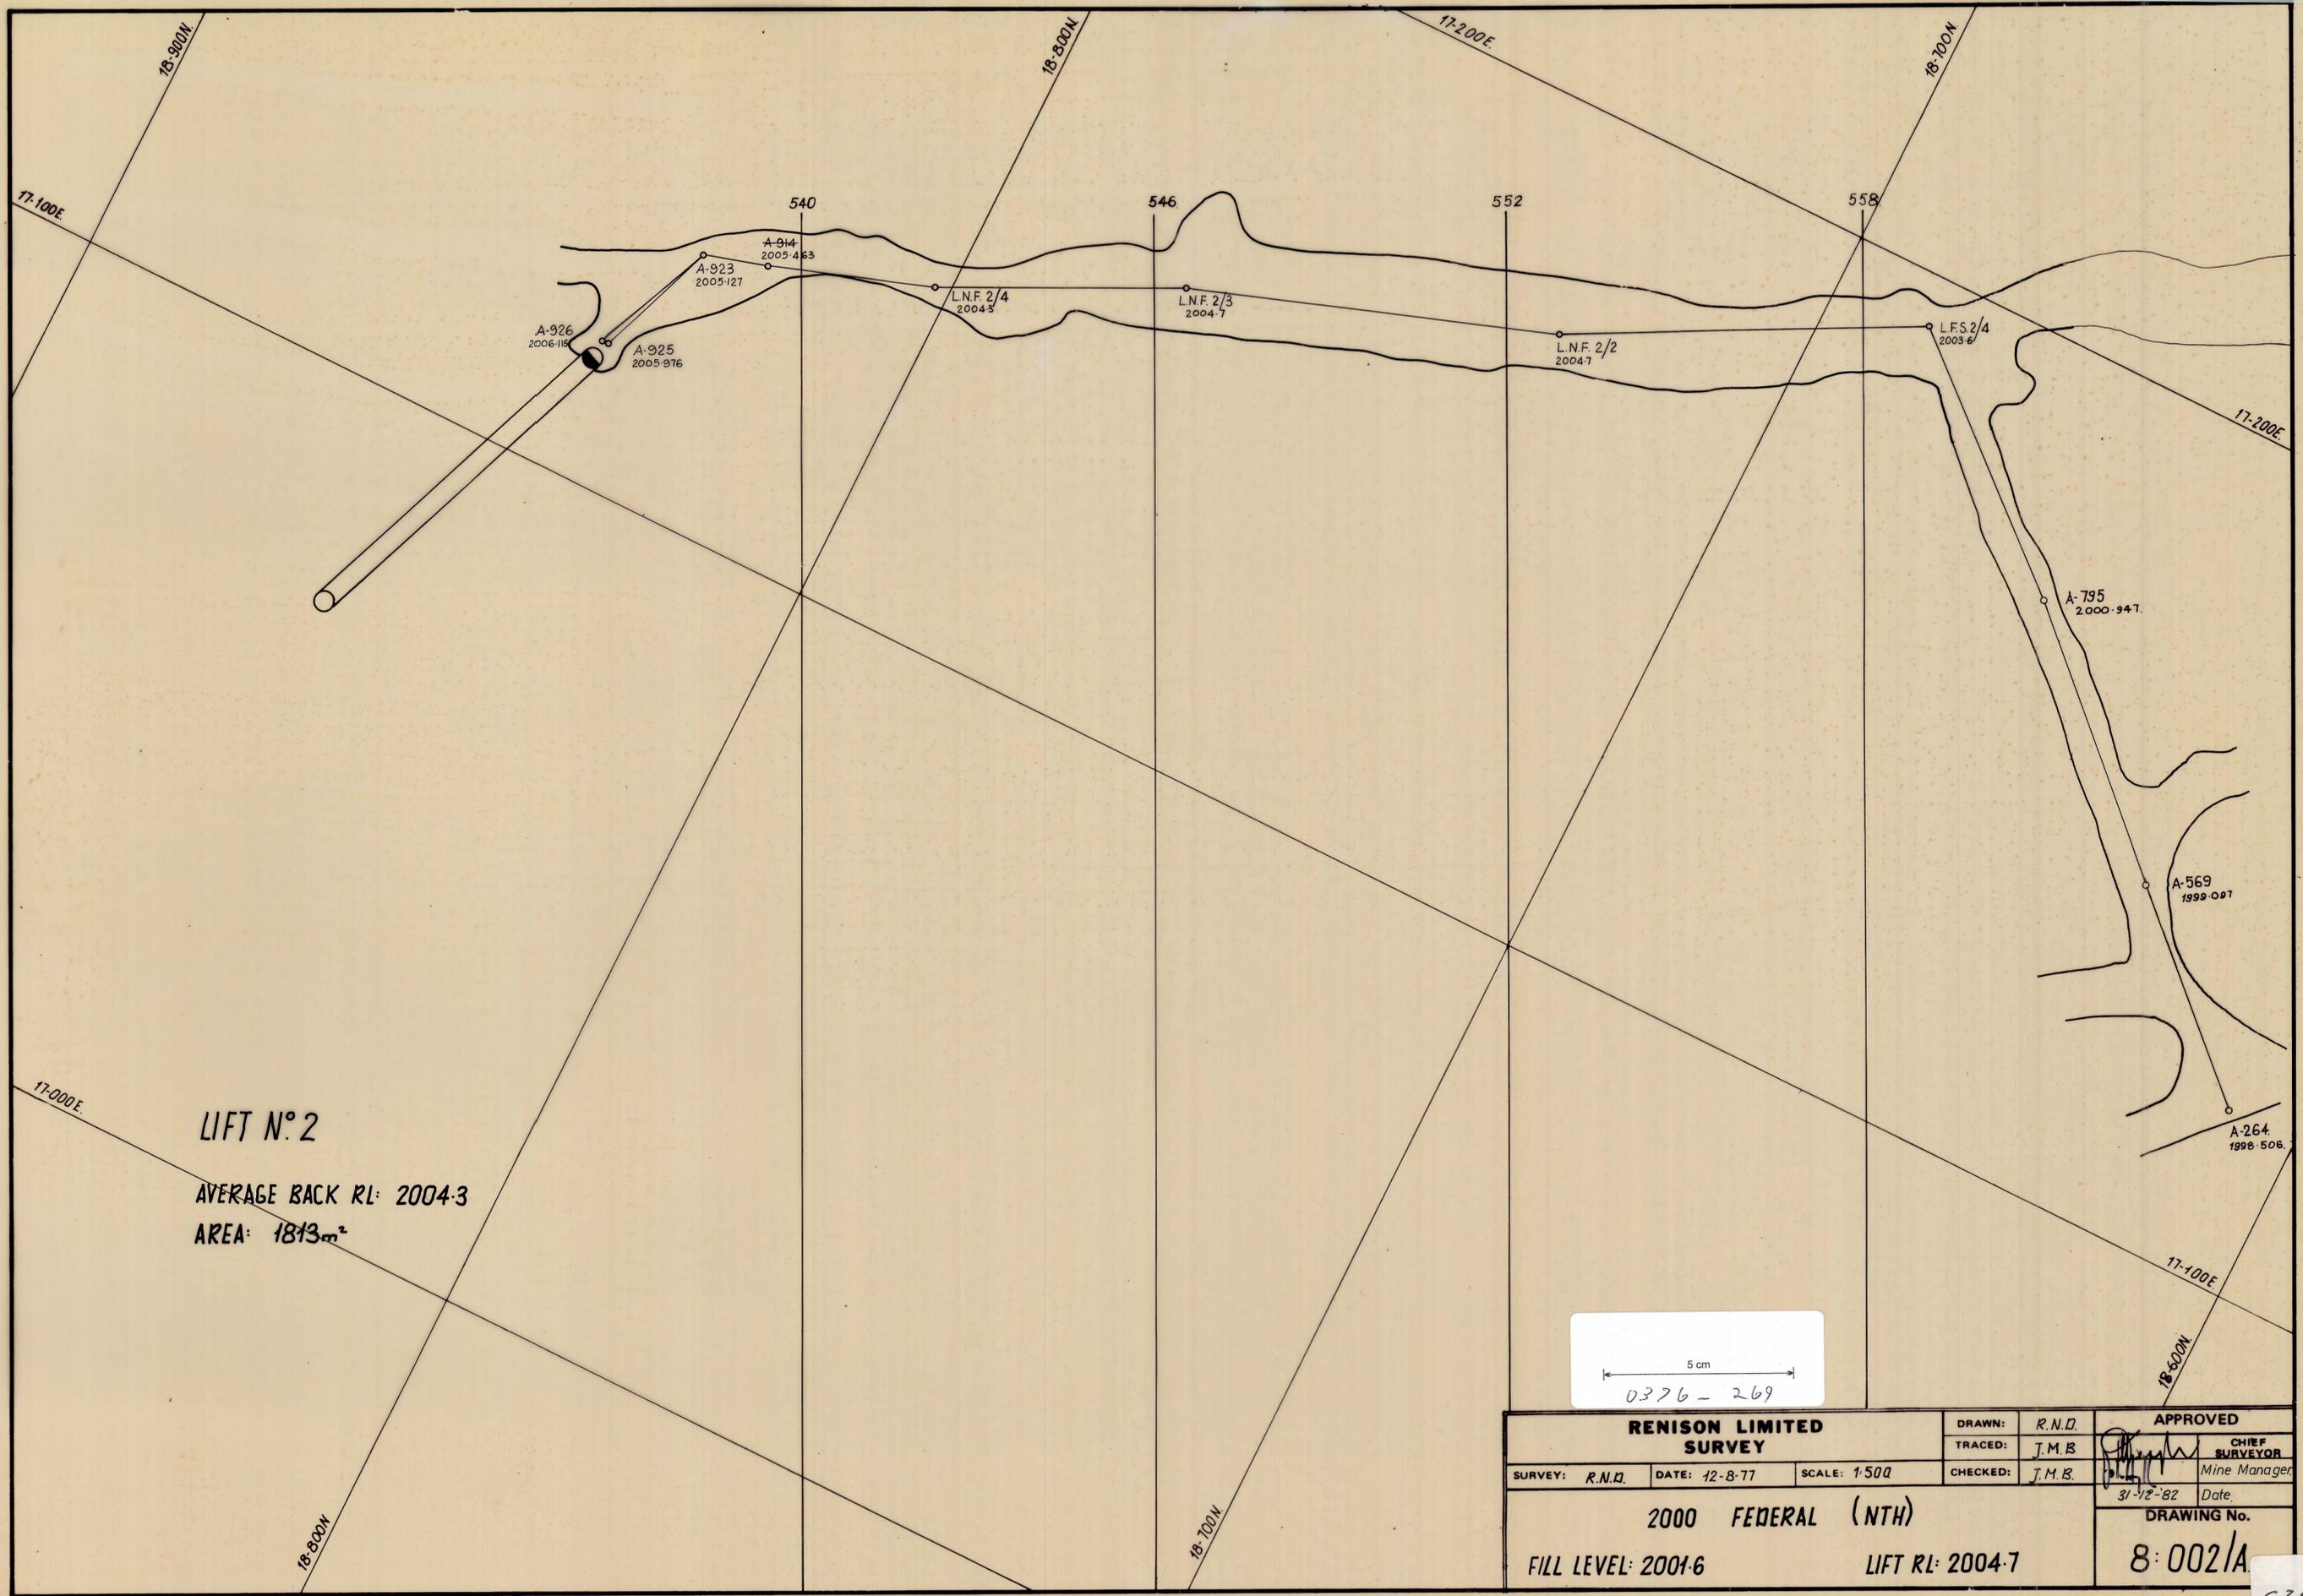

LIFT N° 2
 AVERAGE BACK RL: 2004.3
 AREA: 1813m²

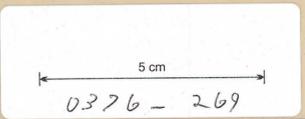

| | | | | | |
|-------------------------------|---------------|--------------|-----------------|-----------------|--|
| RENISON LIMITED SURVEY | | | DRAWN: R.N.D. | APPROVED | |
| | | | TRACED: J.M.B. | CHIEF SURVEYOR | |
| SURVEY: R.N.D. | DATE: 12-8-77 | SCALE: 1:500 | CHECKED: J.M.B. | Mine Manager | |
| 2000 FEDERAL (NTH) | | | 31-12-82 Date. | | |
| FILL LEVEL: 2001.6 | | | DRAWING No. | | |
| LIFT RL: 2004.7 | | | 8:002/A | | |

83063