


LIFT N° 20

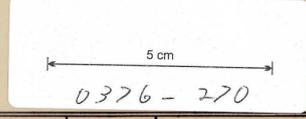

RENISON LIMITED SURVEY		DRAWN: P. Murphy.	APPROVED
		TRACED: S. Fenton.	<i>[Signature]</i> CHIEF SURVEYOR
SURVEY: P.G.M. & F.M.H.	DATE: 11-3-83	SCALE: 1:500.	CHECKED: S. Fenton.
2080 FEDERAL (NTH). FILL LEVEL: Not filled. LIFT RL: 2025-2			31-12-82 Date.
			DRAWING No. 5:009

83060