



0376-271

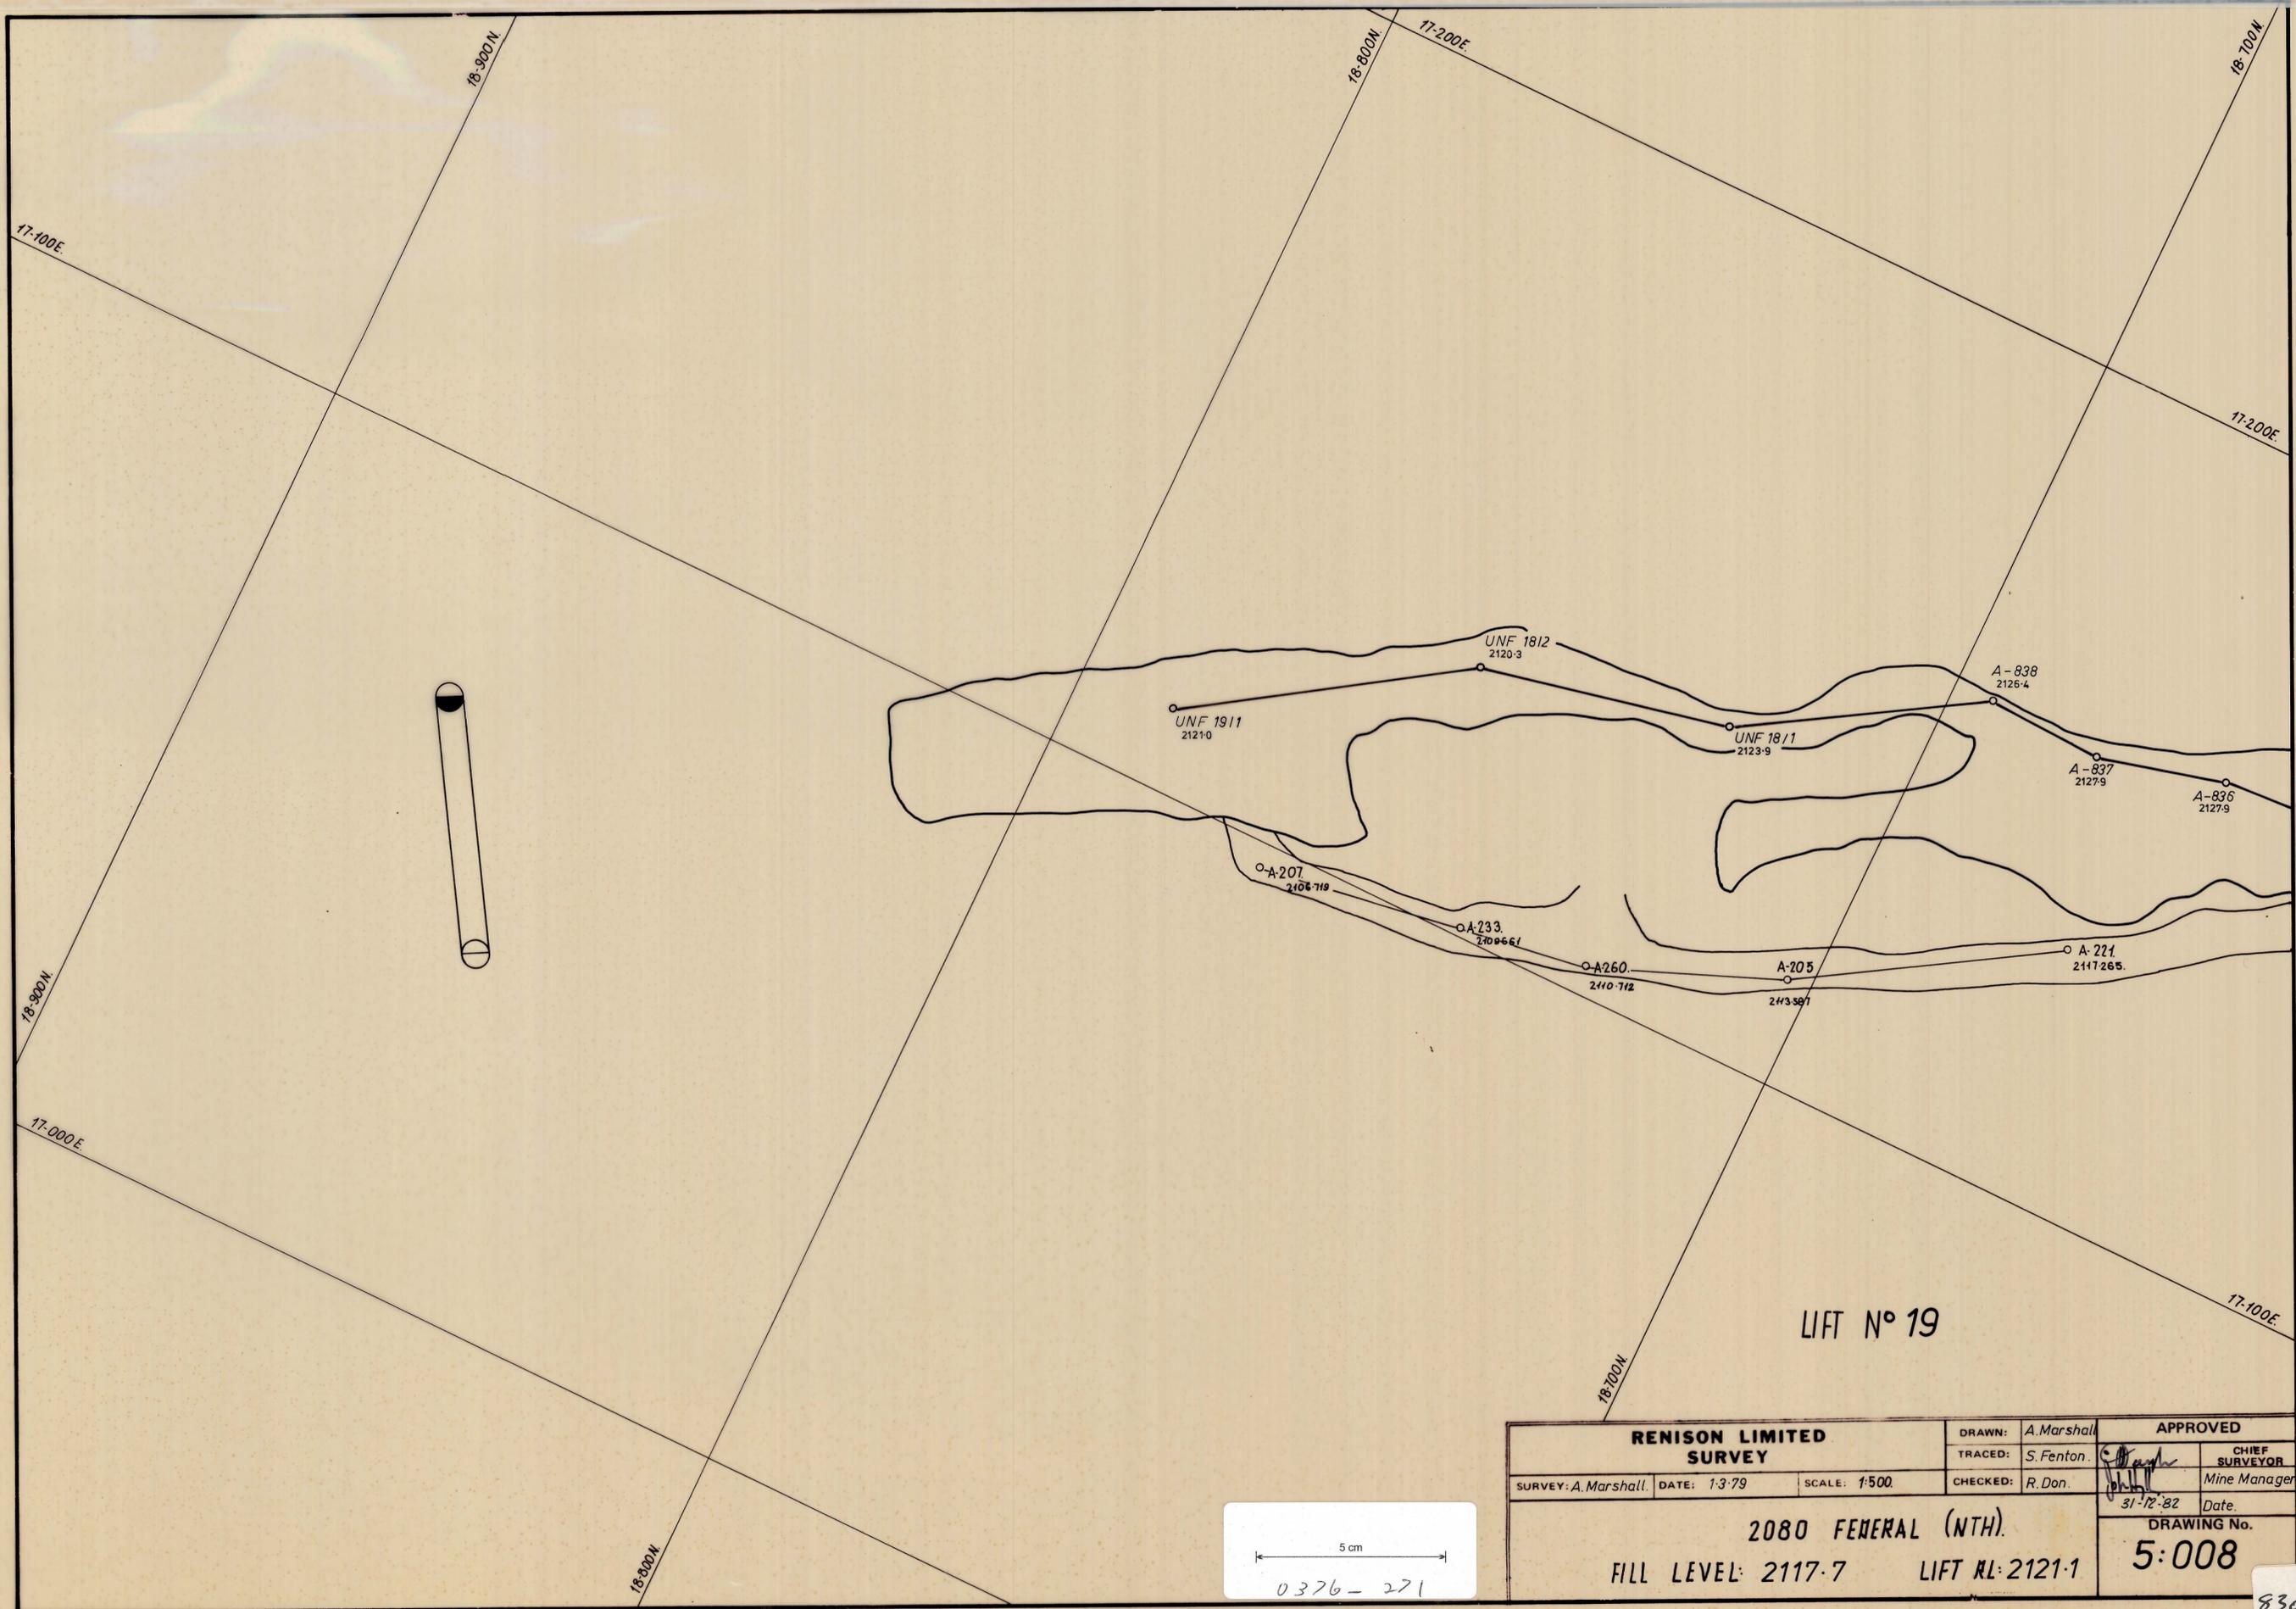

LIFT N° 19

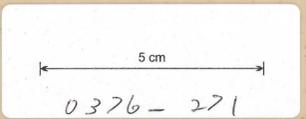

RENISON LIMITED SURVEY		DRAWN: A. Marshall	APPROVED	
SURVEY: A. Marshall		TRACED: S. Fenton	CHIEF SURVEYOR	
DATE: 1-3-79	SCALE: 1:500	CHECKED: R. Don.	Date: 31-12-82	
2080 FEDERAL (NTH).			DRAWING No.	
FILL LEVEL: 2117.7			5:008	
LIFT RL: 2121.1				

83059