
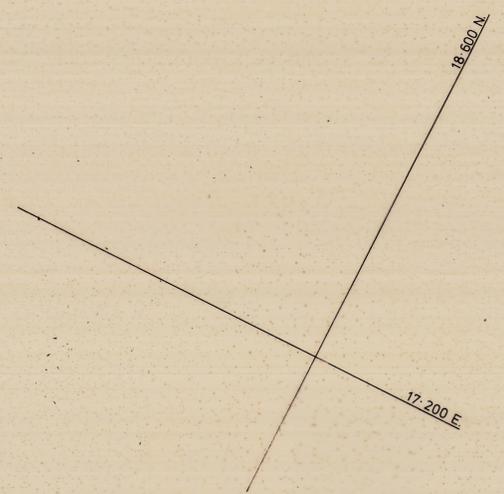


0376-273

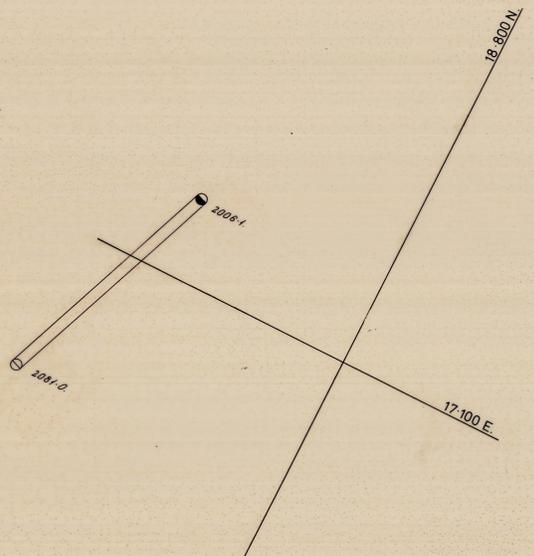

5 cm  
0376-273

DATE	MANAGER	SURVEYOR	RENSON LIMITED SURVEY		DRAWING NO.
11-12-75			DRAWN: F.M.H.	DATE: 11-12-75	SCALE: 1:500
			LOWER FEDERAL STOPE.		13-001
			RISES.		

83061