


0376-274

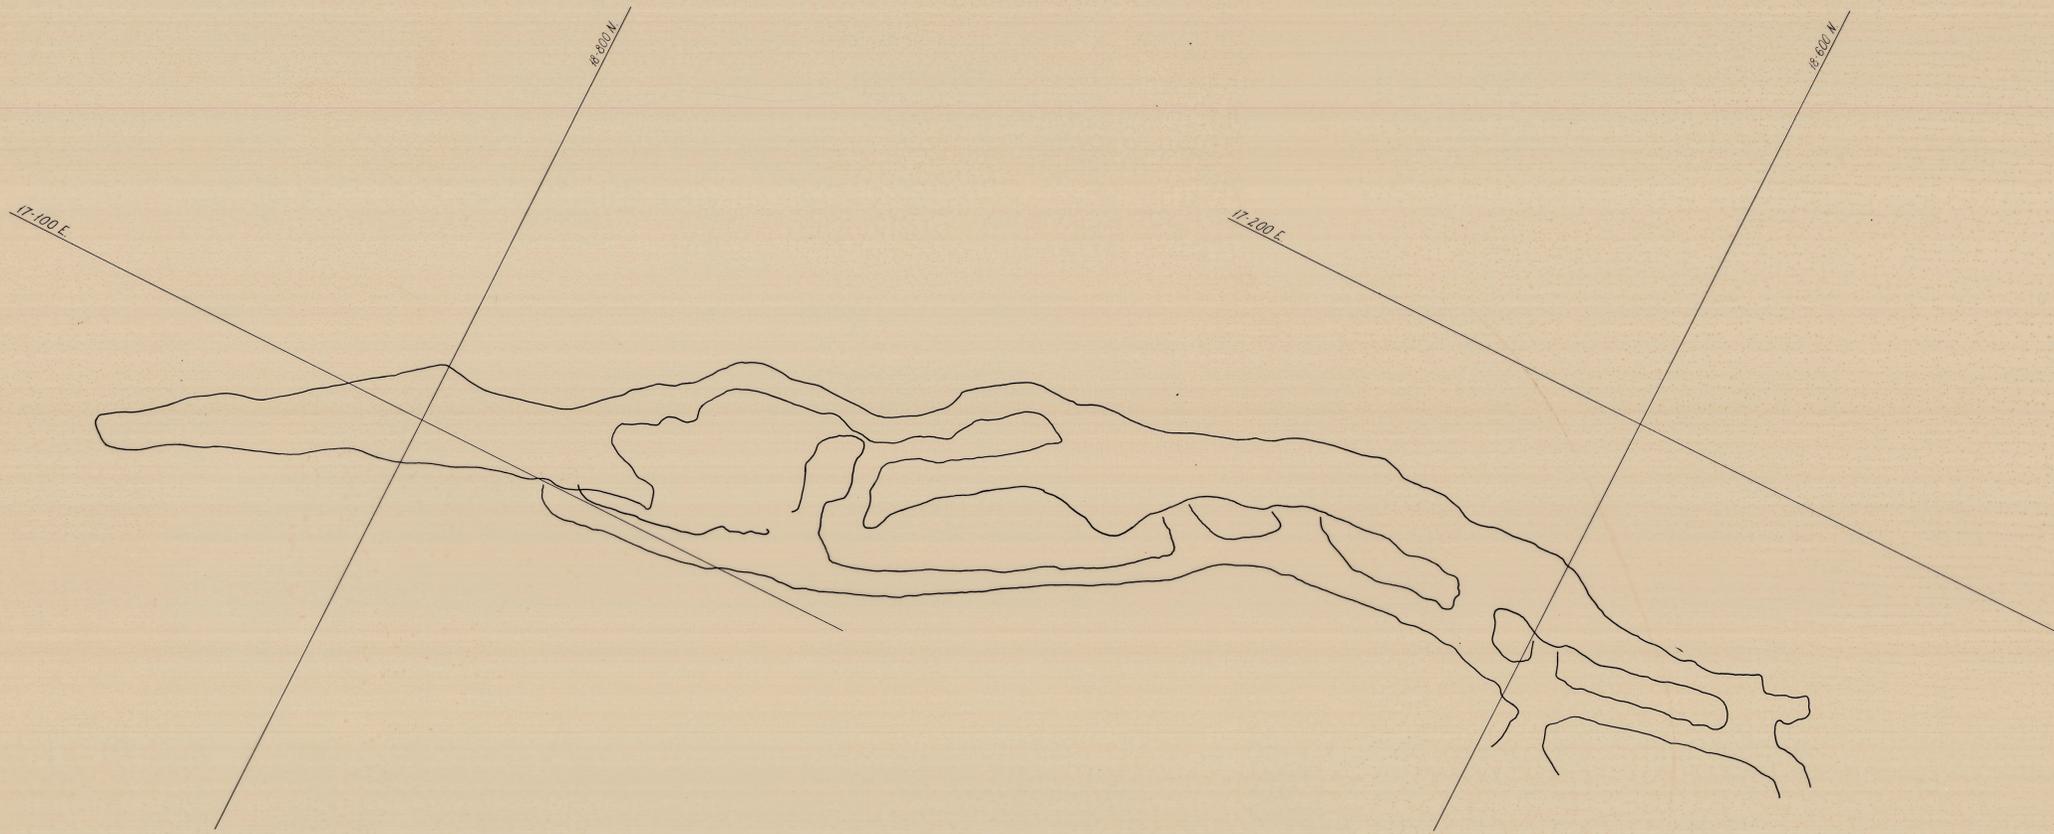

5 cm  
0376-274

DATE	MANAGER	SURVEYOR	RENISON LIMITED		DRAWING No.
31-12-78			SURVEY		
31-12-82			DRAWN, F.M.R.	DATE 1-3-77	SCALE 1:500
			NORTH FEDERAL STOPE LEVEL: 2116.		12-038
			SOUTH FEDERAL STOPE LEVEL: 2125.		

83058