


0376-275

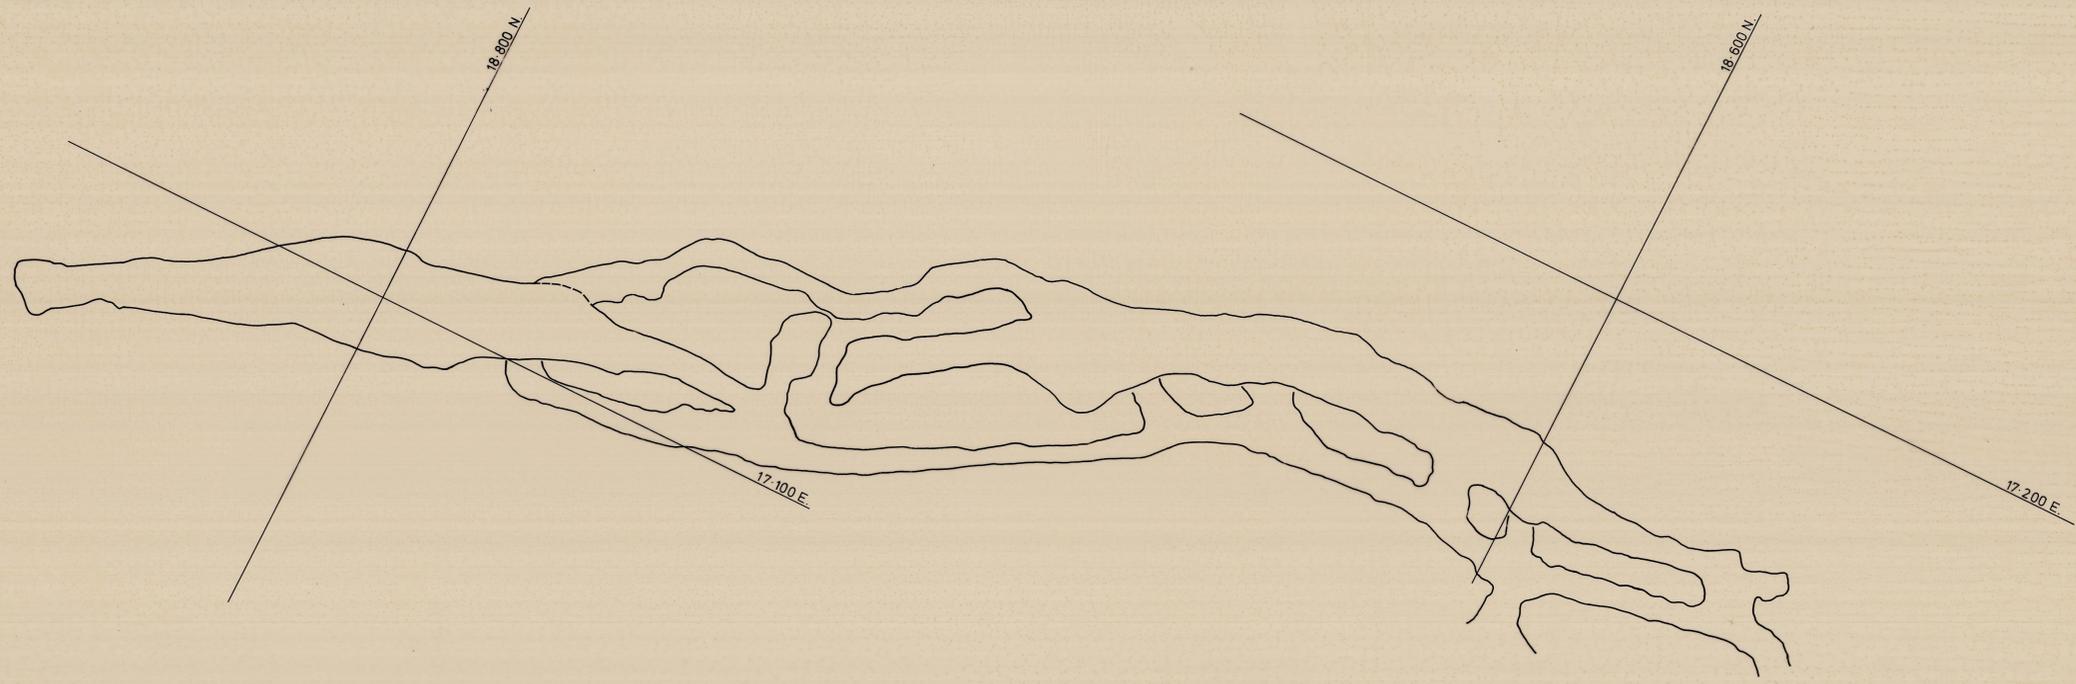

5 cm
0376-275

DATE	MANAGER	SURVEYOR	REINSON LIMITED		DRAWING NO.
31-12-75			SURVEY		
31-12-75			DRAWN: FMH	DATE: 9-12-75	SCALE: 1:500
			NORTH FEDERAL STOPE. LEVEL: 2108.		12-038
			SOUTH FEDERAL STOPE. LEVEL: 2125.		

83057