


0376-276

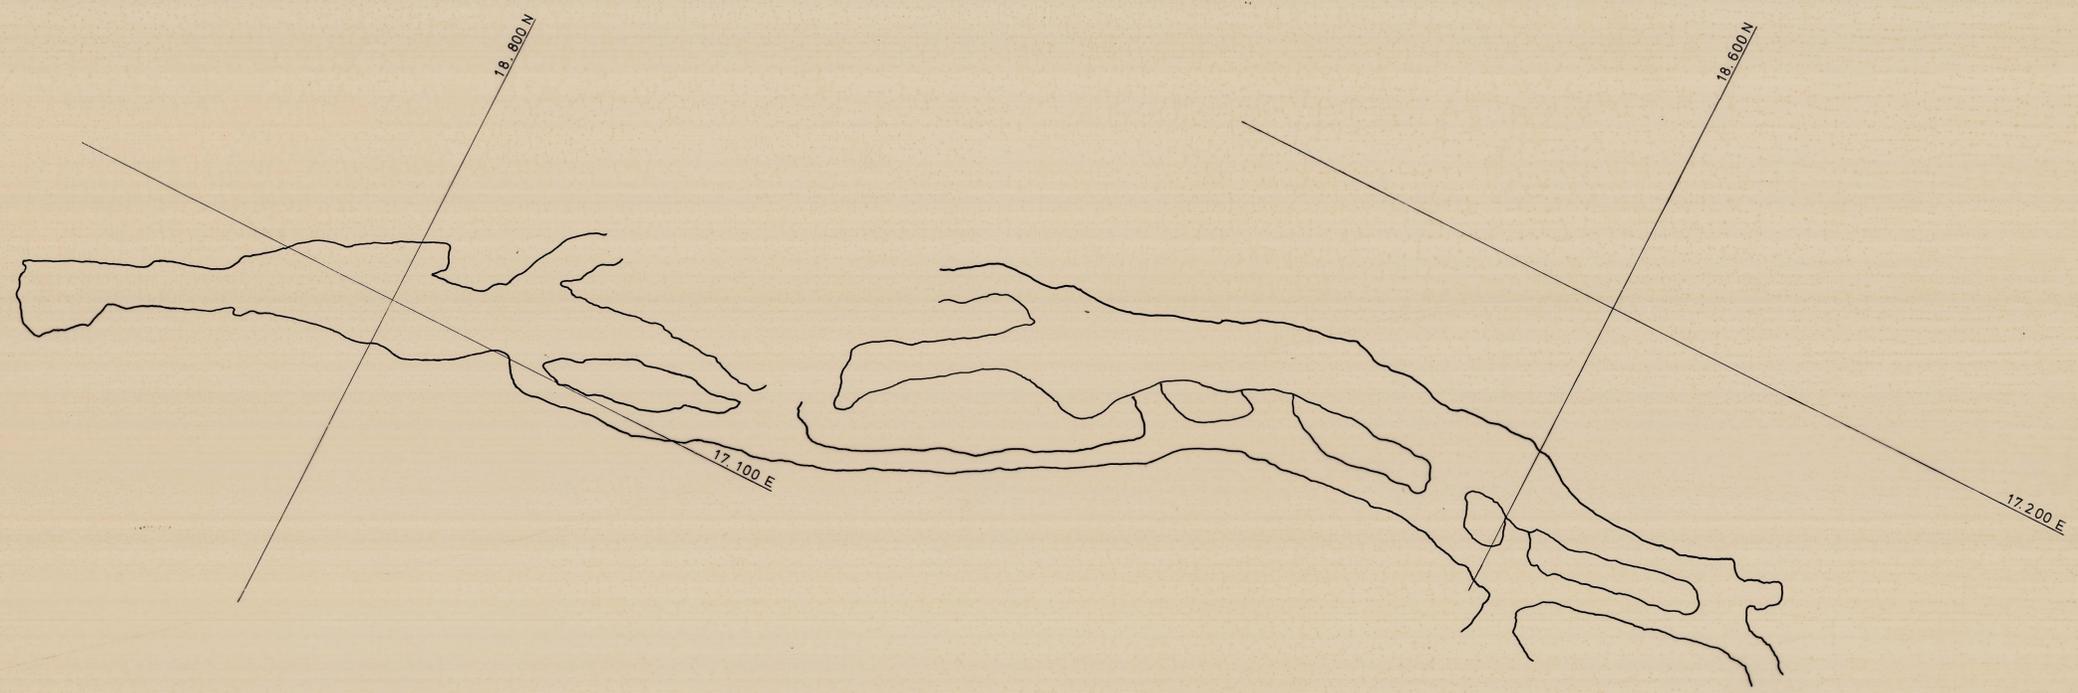

5 cm  
0376-276

DATE	DESIGNER	CHECKED	REVISIONS		DRAWING NO.
3/12/74	[Signature]	[Signature]			12: 038
DRAWN: A.J.M.			DATE: 13-11-74	SCALE: 1:500	
NORTH FEDERAL STOPE. LEVEL: 2105					
SOUTH FEDERAL STOPE. LEVEL: 2125					

83056