


0376-278

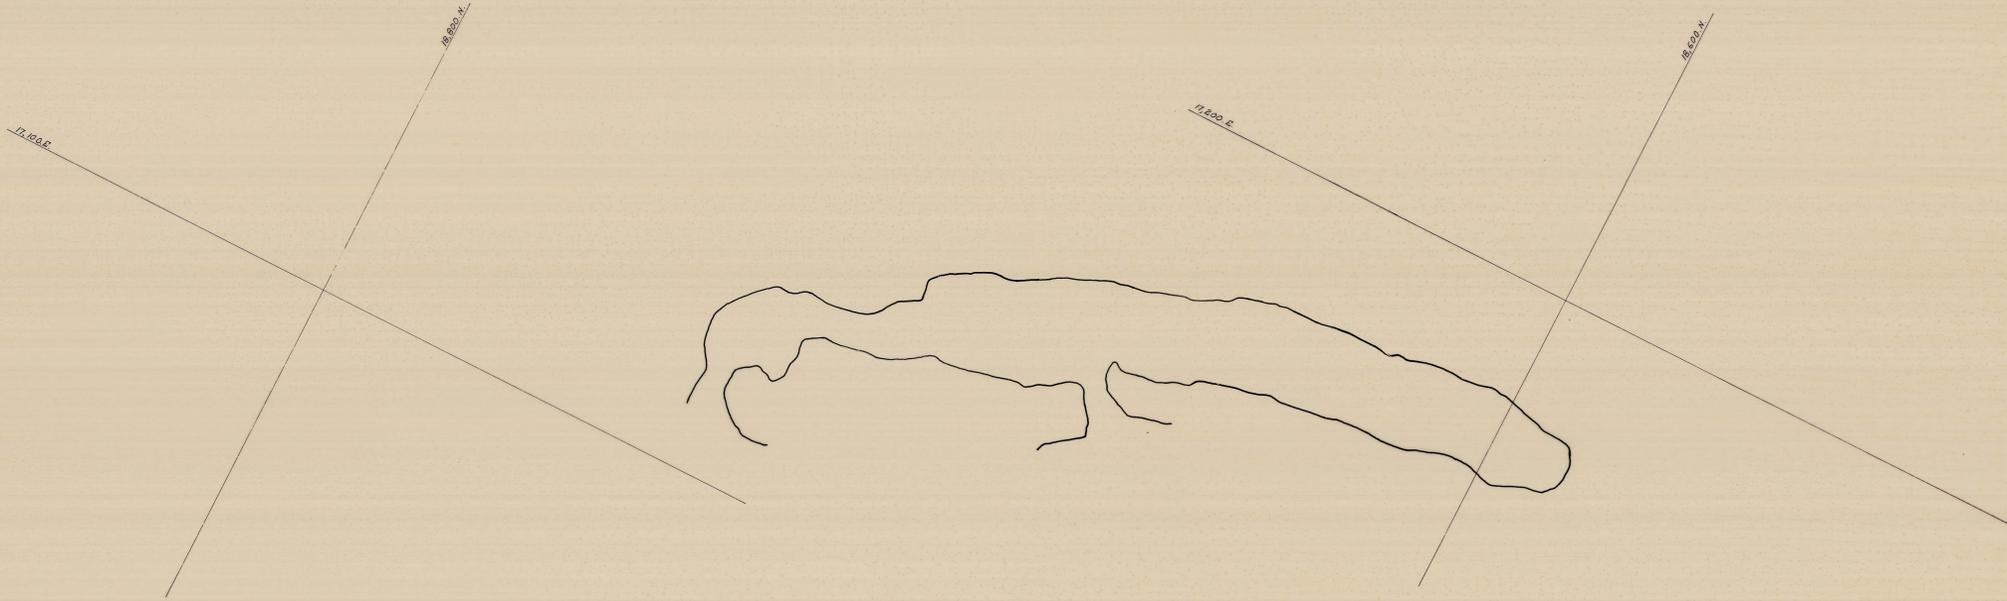

5cm  
0376-278

| DATE    | DRAWN              | REVISION           | RENISON LIMITED SURVEY   |              | DRAWING NO.  |
|---------|--------------------|--------------------|--------------------------|--------------|--------------|
| 3-12-82 | <i>[Signature]</i> | <i>[Signature]</i> | DRAWN: P.W.K.            | DATE: 7-3-79 | SCALE: 1:500 |
|         |                    |                    | FEDERAL STOPE LEVEL 2115 |              | 12:038       |

83054