


0376-279

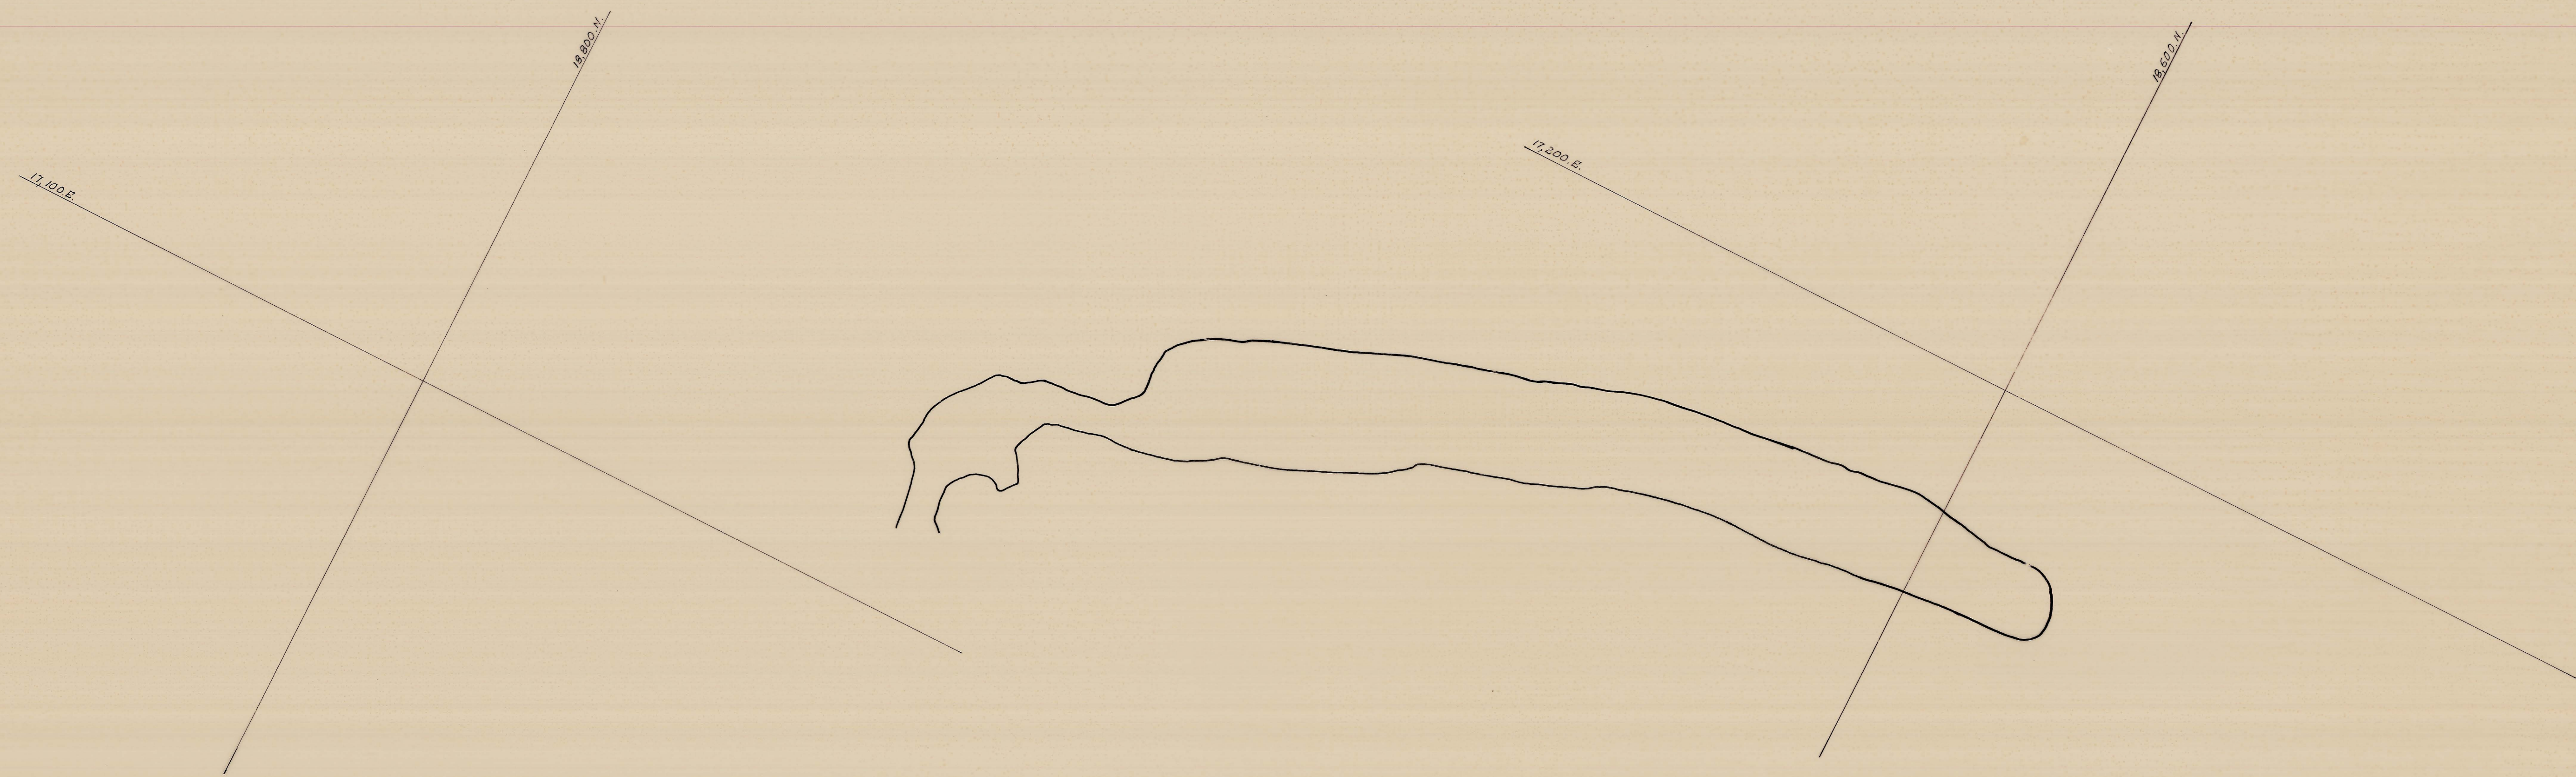

DATE 8-18-82		MANAGER [Signature]		SURVEYOR [Signature]		RENISON LIMITED SURVEY		DRAWING N°	
DRAWN: P.W.K.		DATE: 7-3-83		SCALE: 1" = 500'		FEDERAL STOPE LEVEL 2110		12:038	

83053