
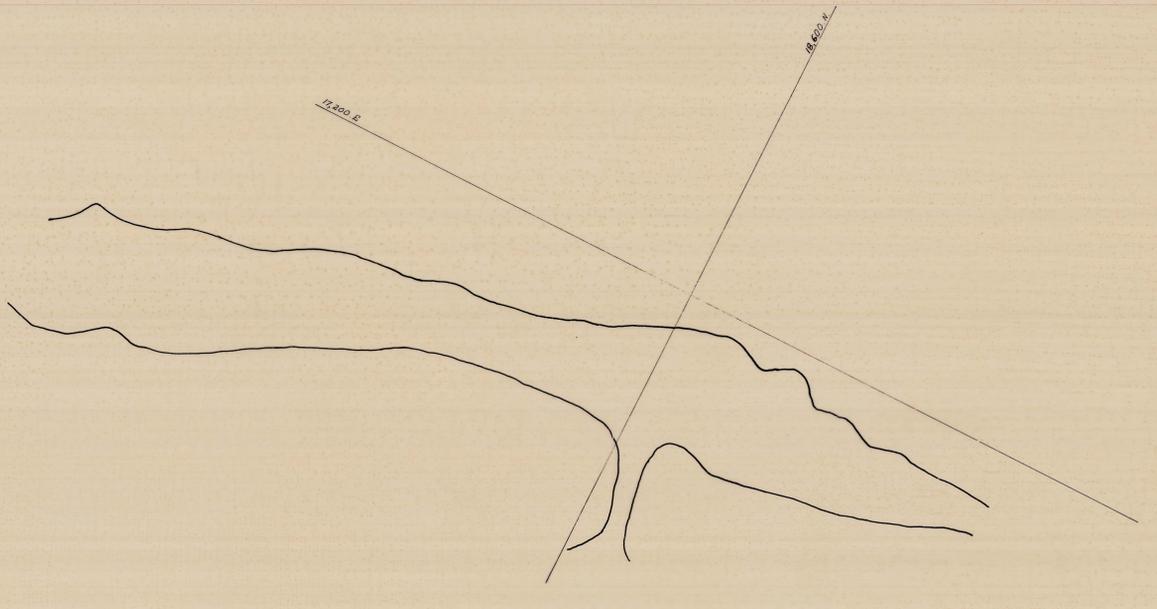


0376-280

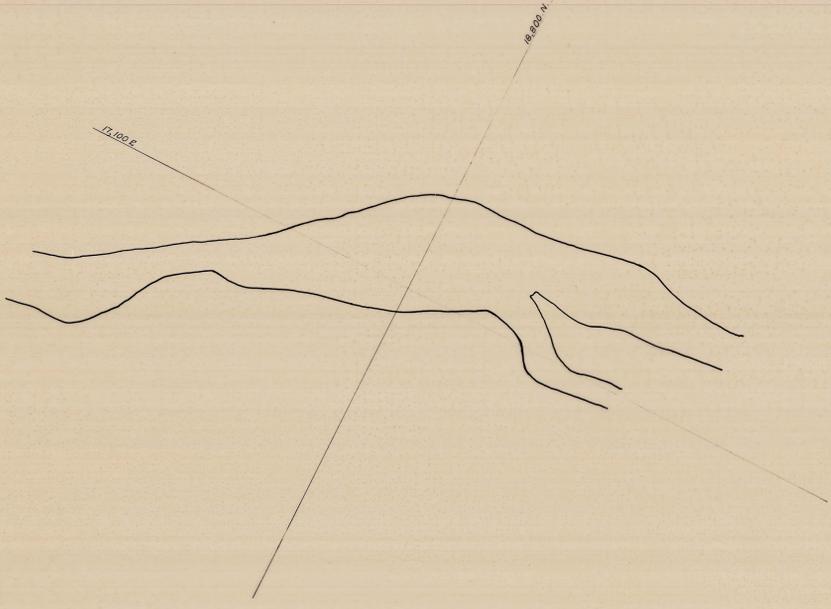

5 cm

0376-280

DATE	MANAGER	SURVEYOR	RENSON LIMITED		DRAWING NO
31-12-82	W.H.	C.H.	SURVEY		12-038
			DRAWN: P.W.K.	DATE: 7-3-78	SCALE: 1:500
			FEDERAL STOPE		
			LEVEL 2100		

83051