


0376-281

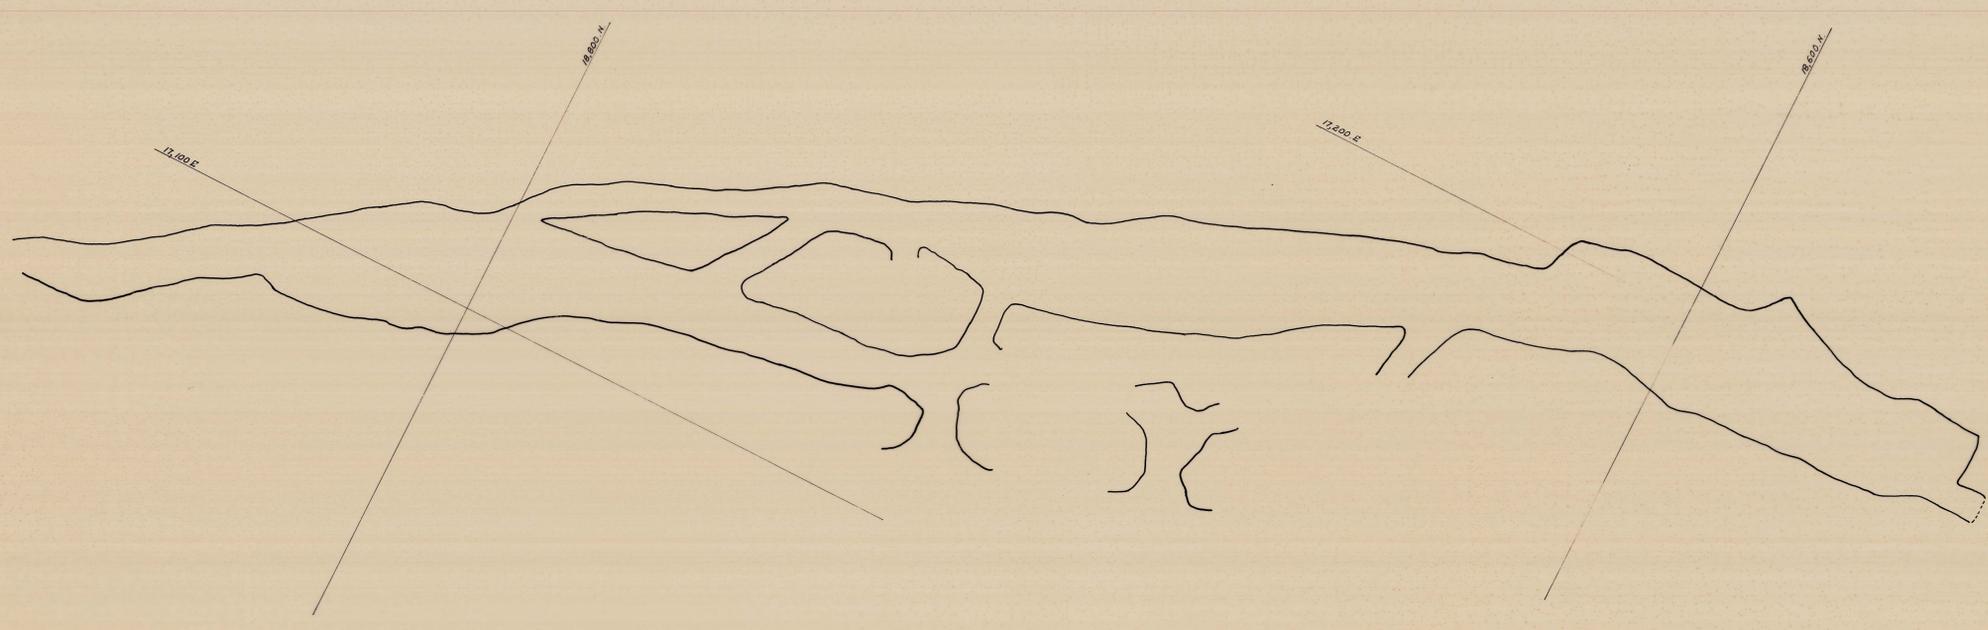

5cm
0376-281

DATE	MANAGER	SURVEYOR	REINSON LIMITED		DRAWING NO.
8-12-82			SURVEY		12-038
			DRAWN: P.W.K.	DATE: 7-3-78	SCALE: 1:500
			FEDERAL STONE		
			LEVEL 2090		

83050