


0376-282

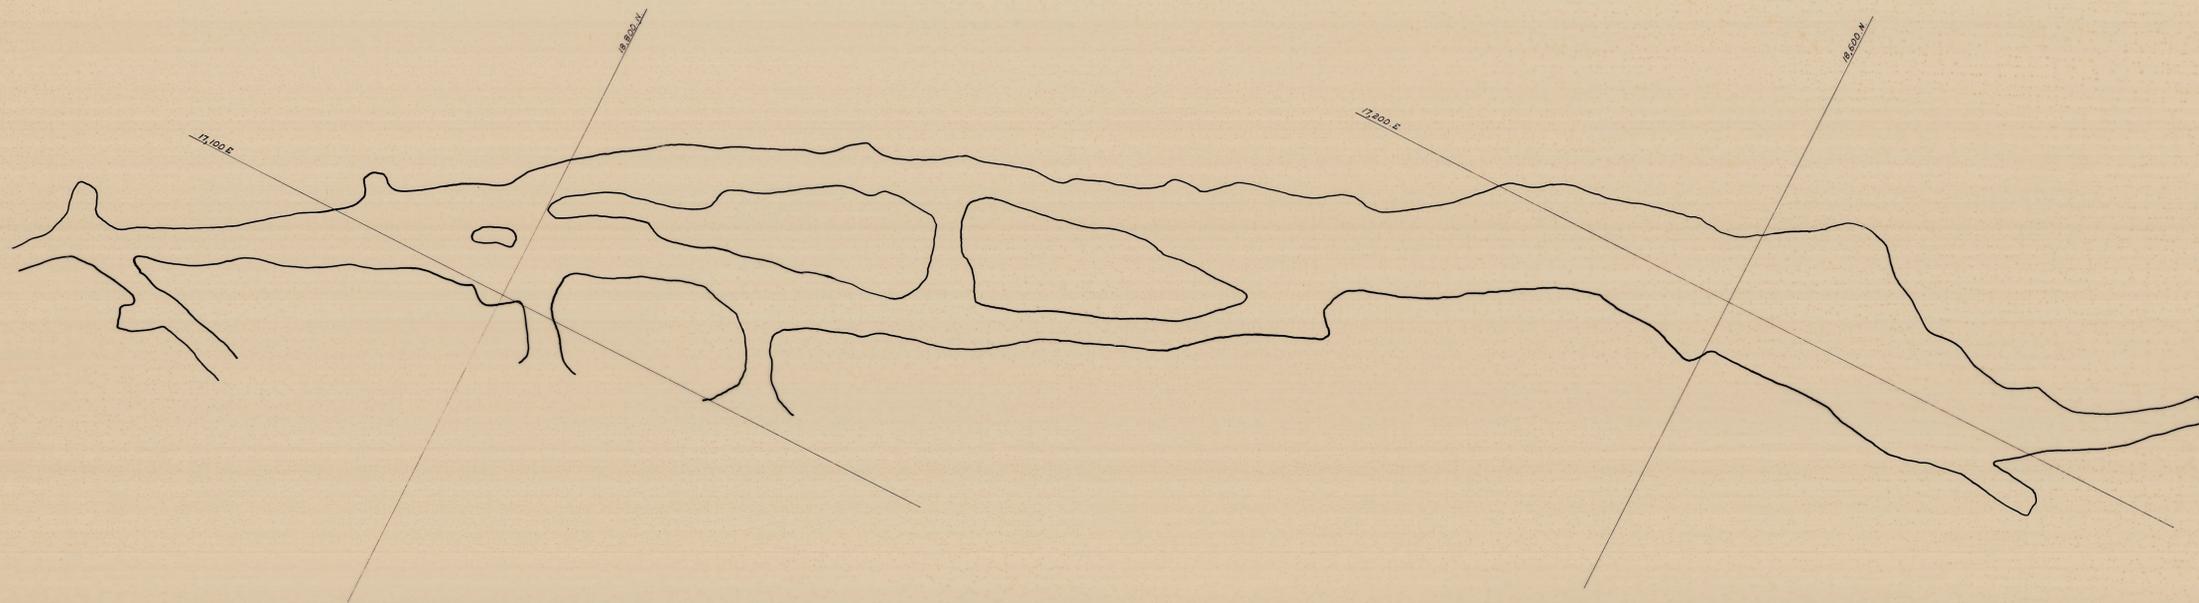

5m
0376-282

DATE	PLANNER	SURVEYOR	REINSON LIMITED		DRAWING NO.
7-3-78			SURVEY		
DRAWN: P.W.K.		DATE: 7-3-78	SCALE: 1:500		12:038
FEDERAL STONE LEVEL 2080					

83049