


0376-283

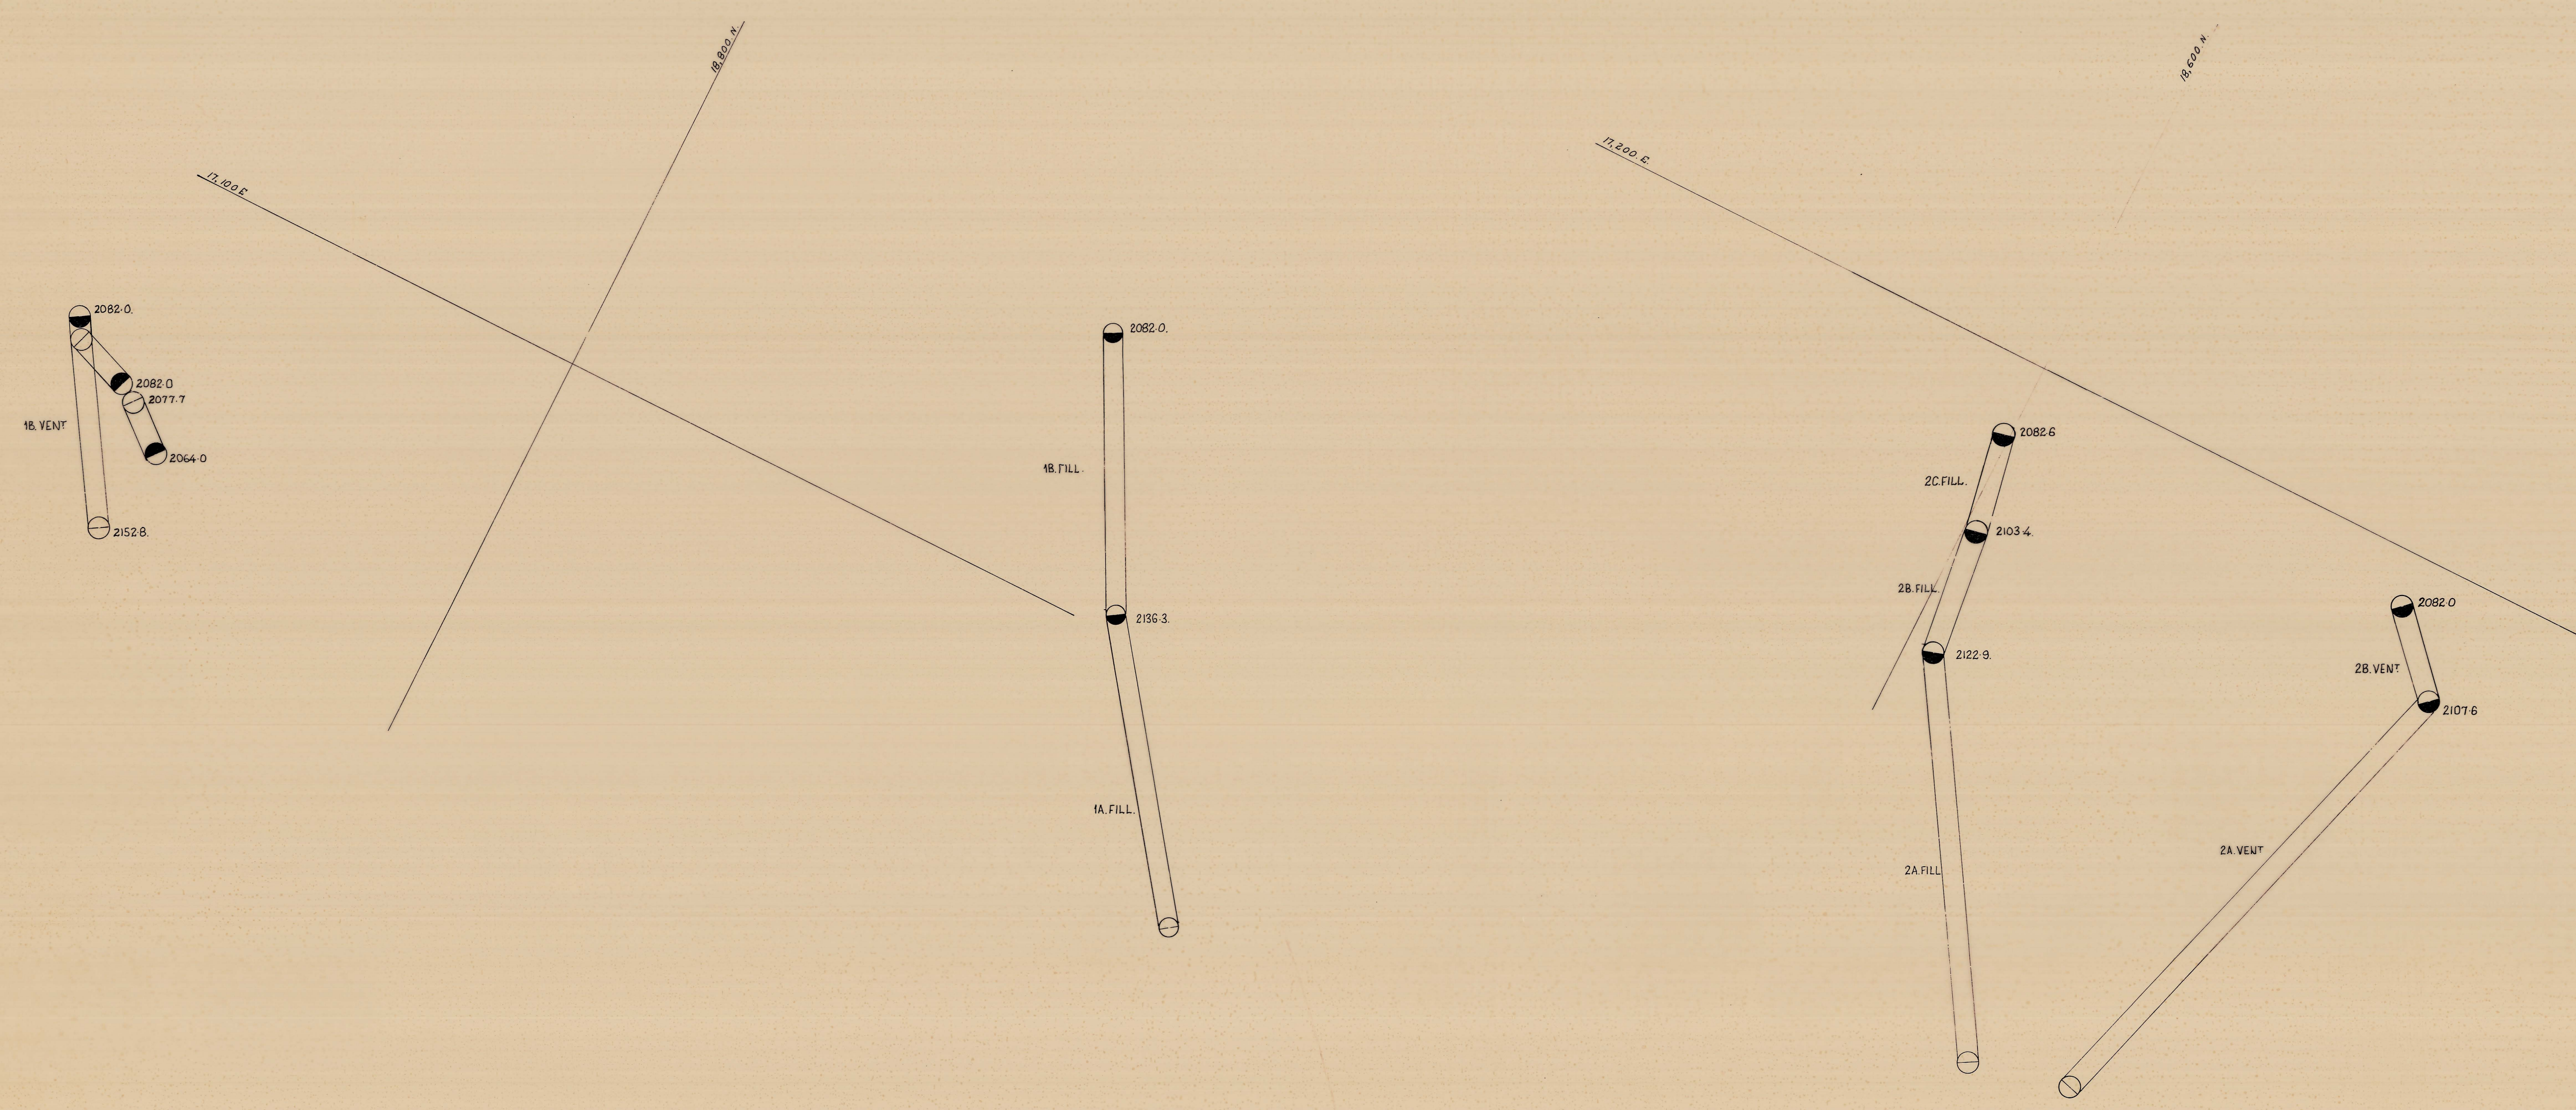

5 cm

0376-283

DATE	MANAGER	SURVEYOR	REINSON LIMITED		DRAWING NO.	
31-12-82	<i>[Signature]</i>	<i>[Signature]</i>	SURVEY			
			DRAWN: P.W.K.	DATE: 7-8-73	12:038	
			SCALE: 1:500			
			FEDERAL STOPE			
			COMPOSITE RISES			
			8304			

83048