


0376-284

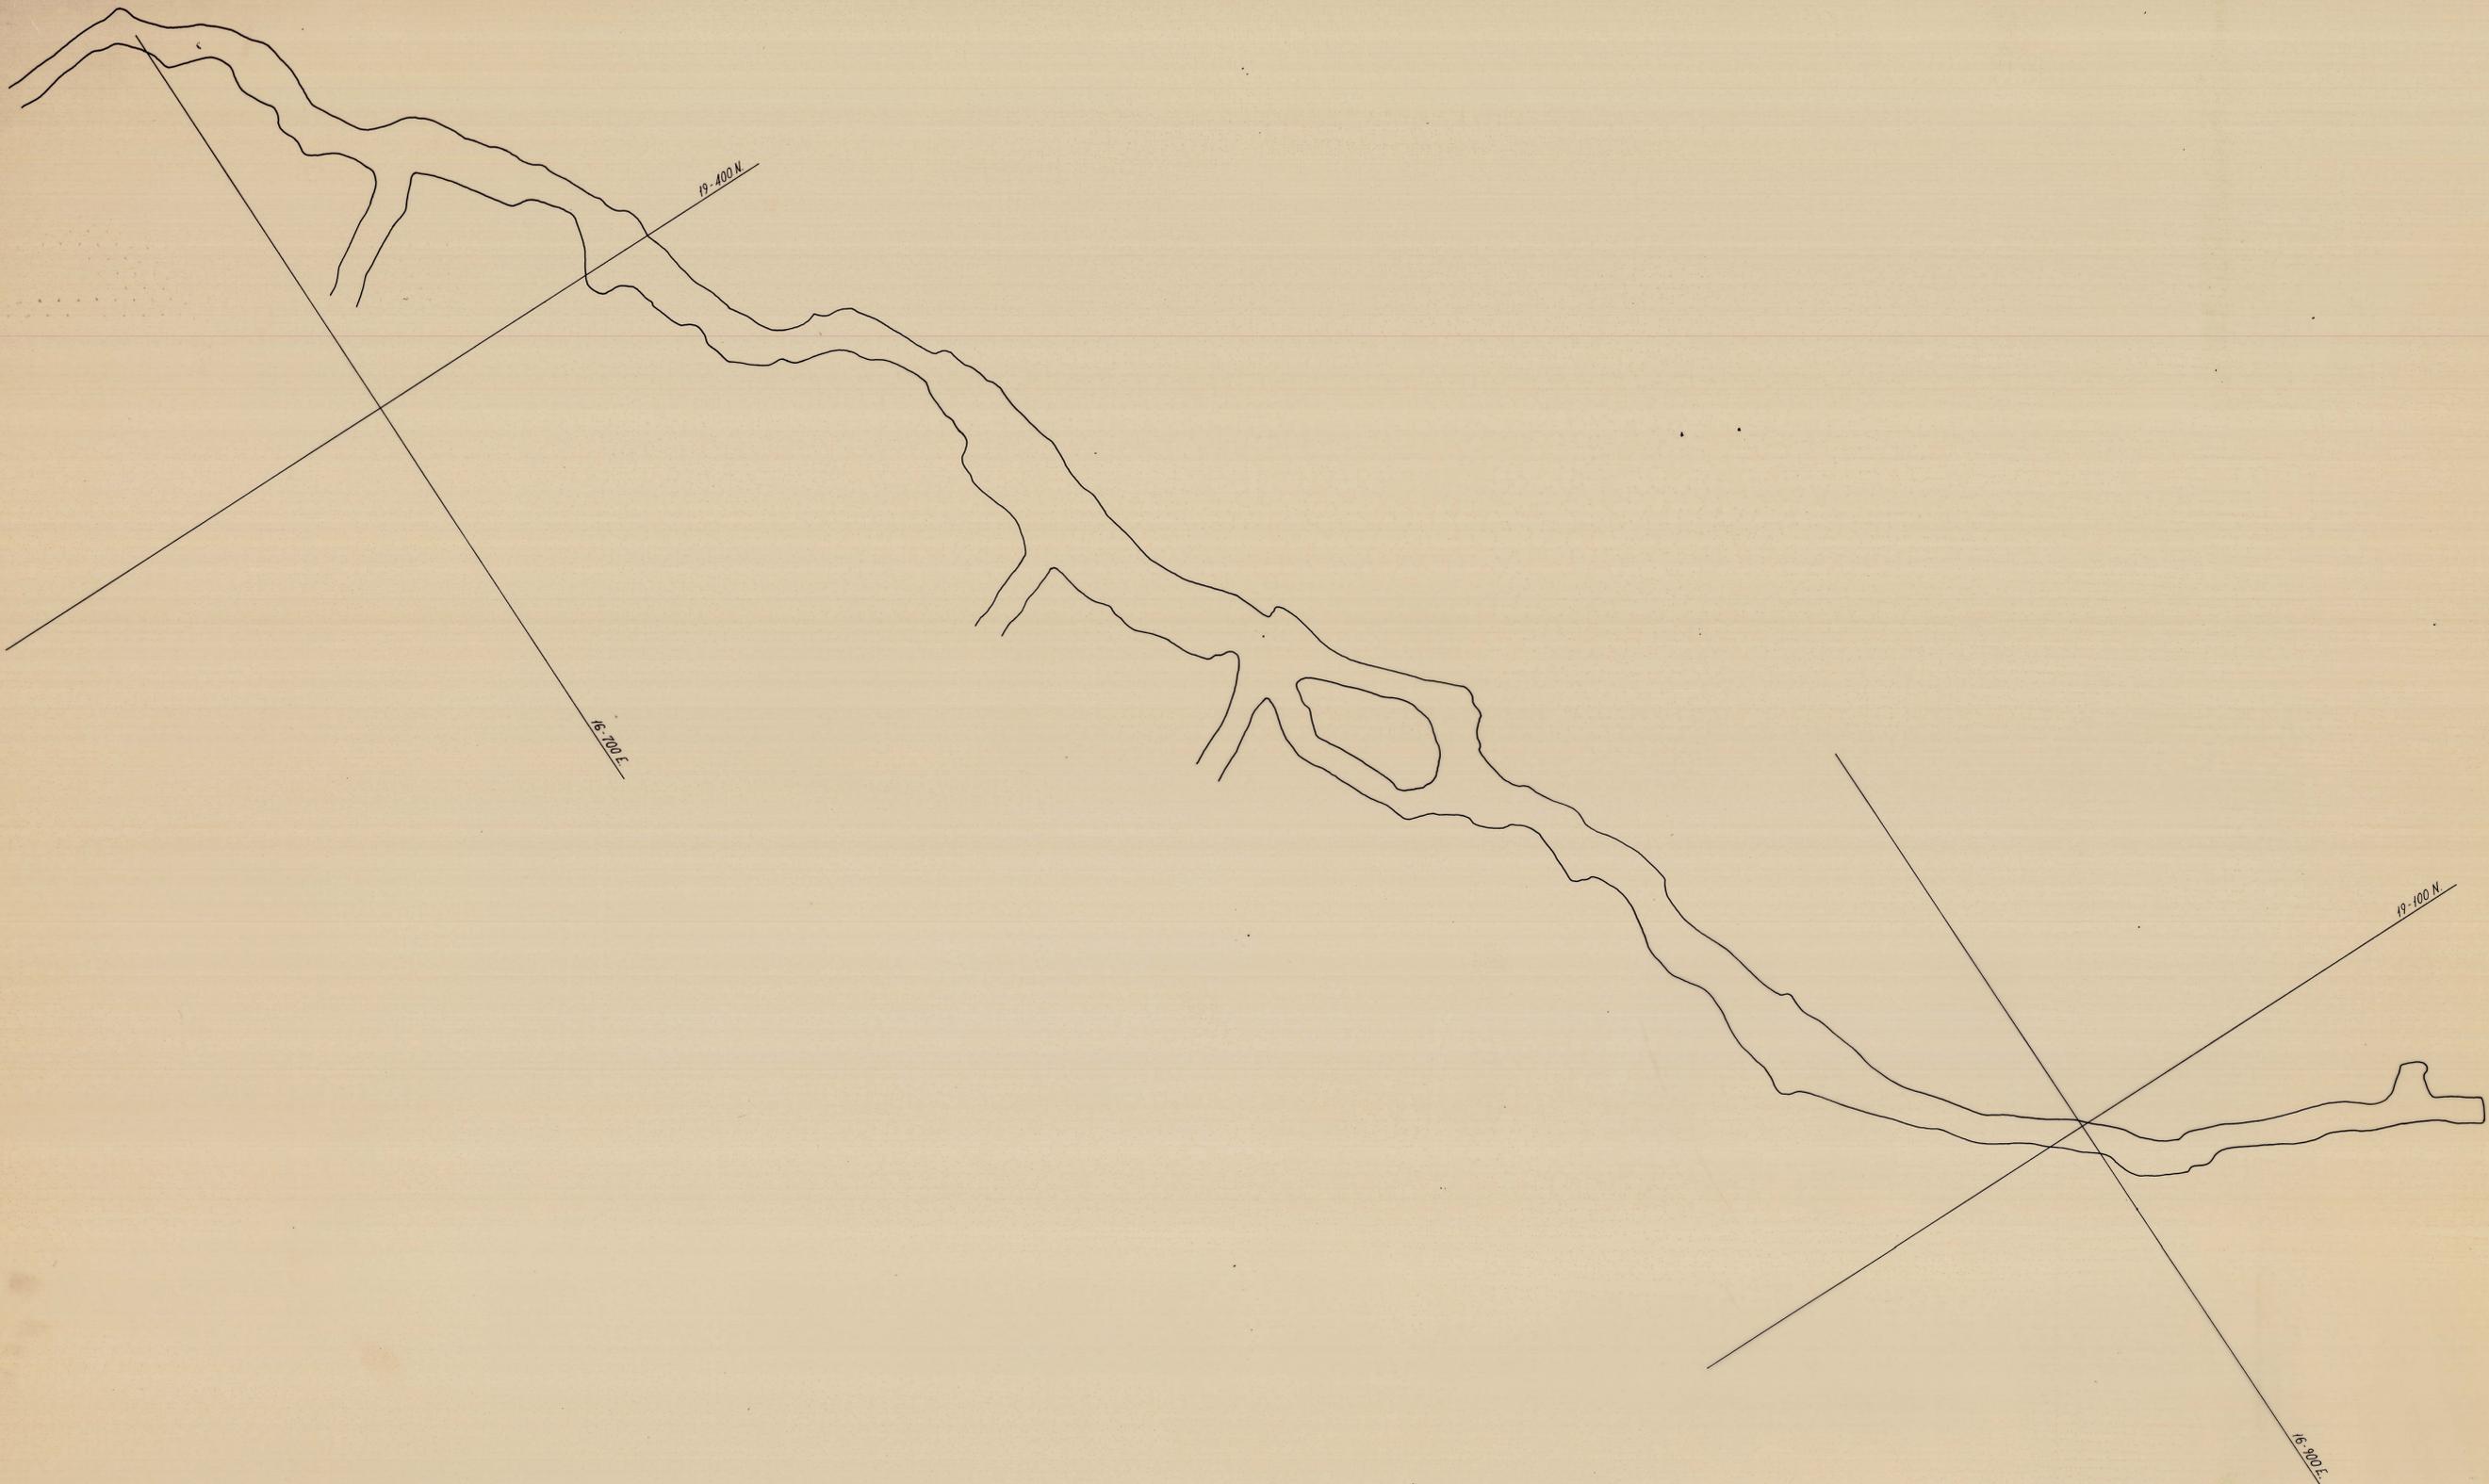

5cm
0376-284

DATE	MANAGER	SURVEYOR	RENISON LIMITED SURVEY		DRAWING No.
31-12-82			DRAWN	DATE 11-2-77	76:001
				SCALE 1:500	
			1960 PENZANCE STOPE		
			LEVEL: 1965		

83178