
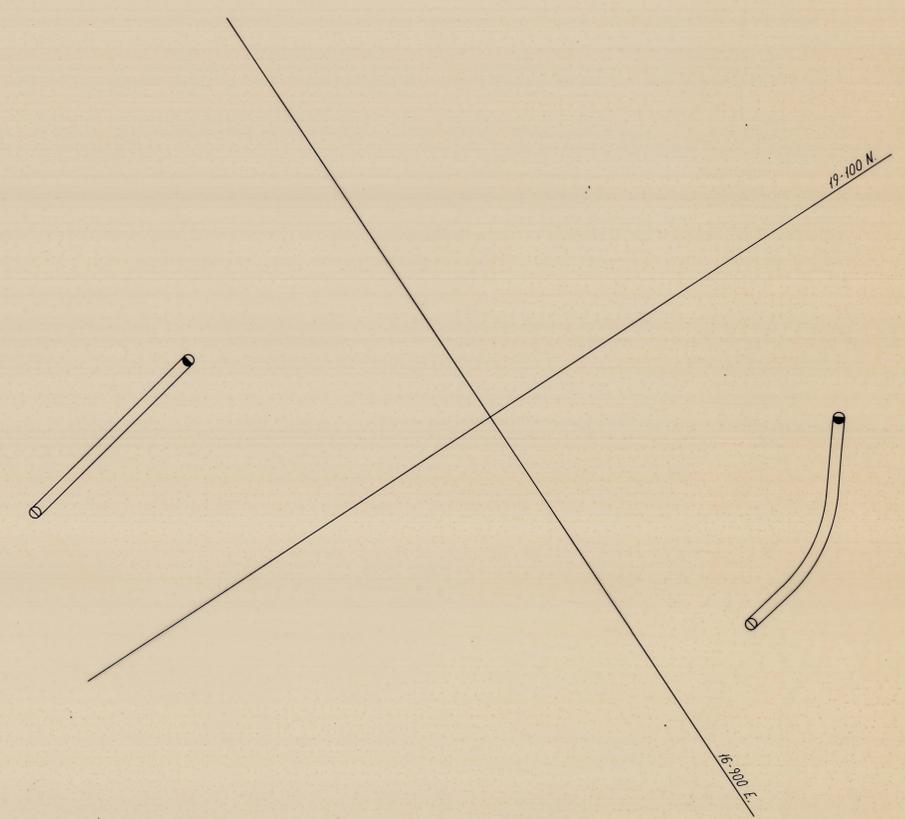


0376-286

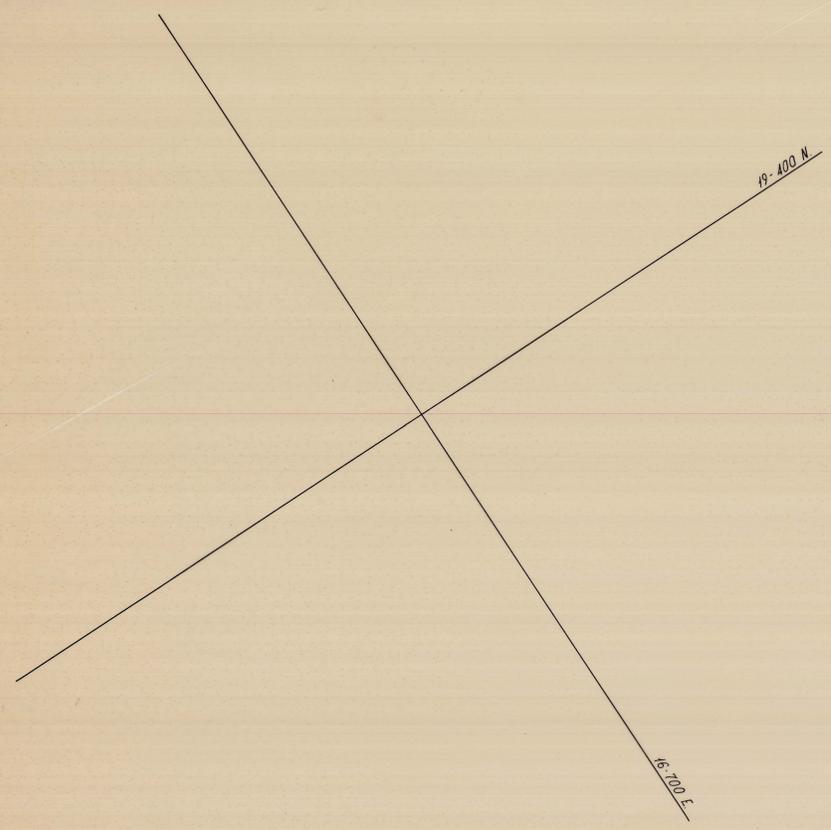

5 cm

0376-286

DATE	MANAGER	SURVEYOR	RENISON LIMITED SURVEY		DRAWING No.
31-12-76			DRAWN: F.M.H.	DATE: 11-2-77	SCALE: 1:500
			1960 PENZANCE STOPE RISES		76:001.

83176