


0376-287

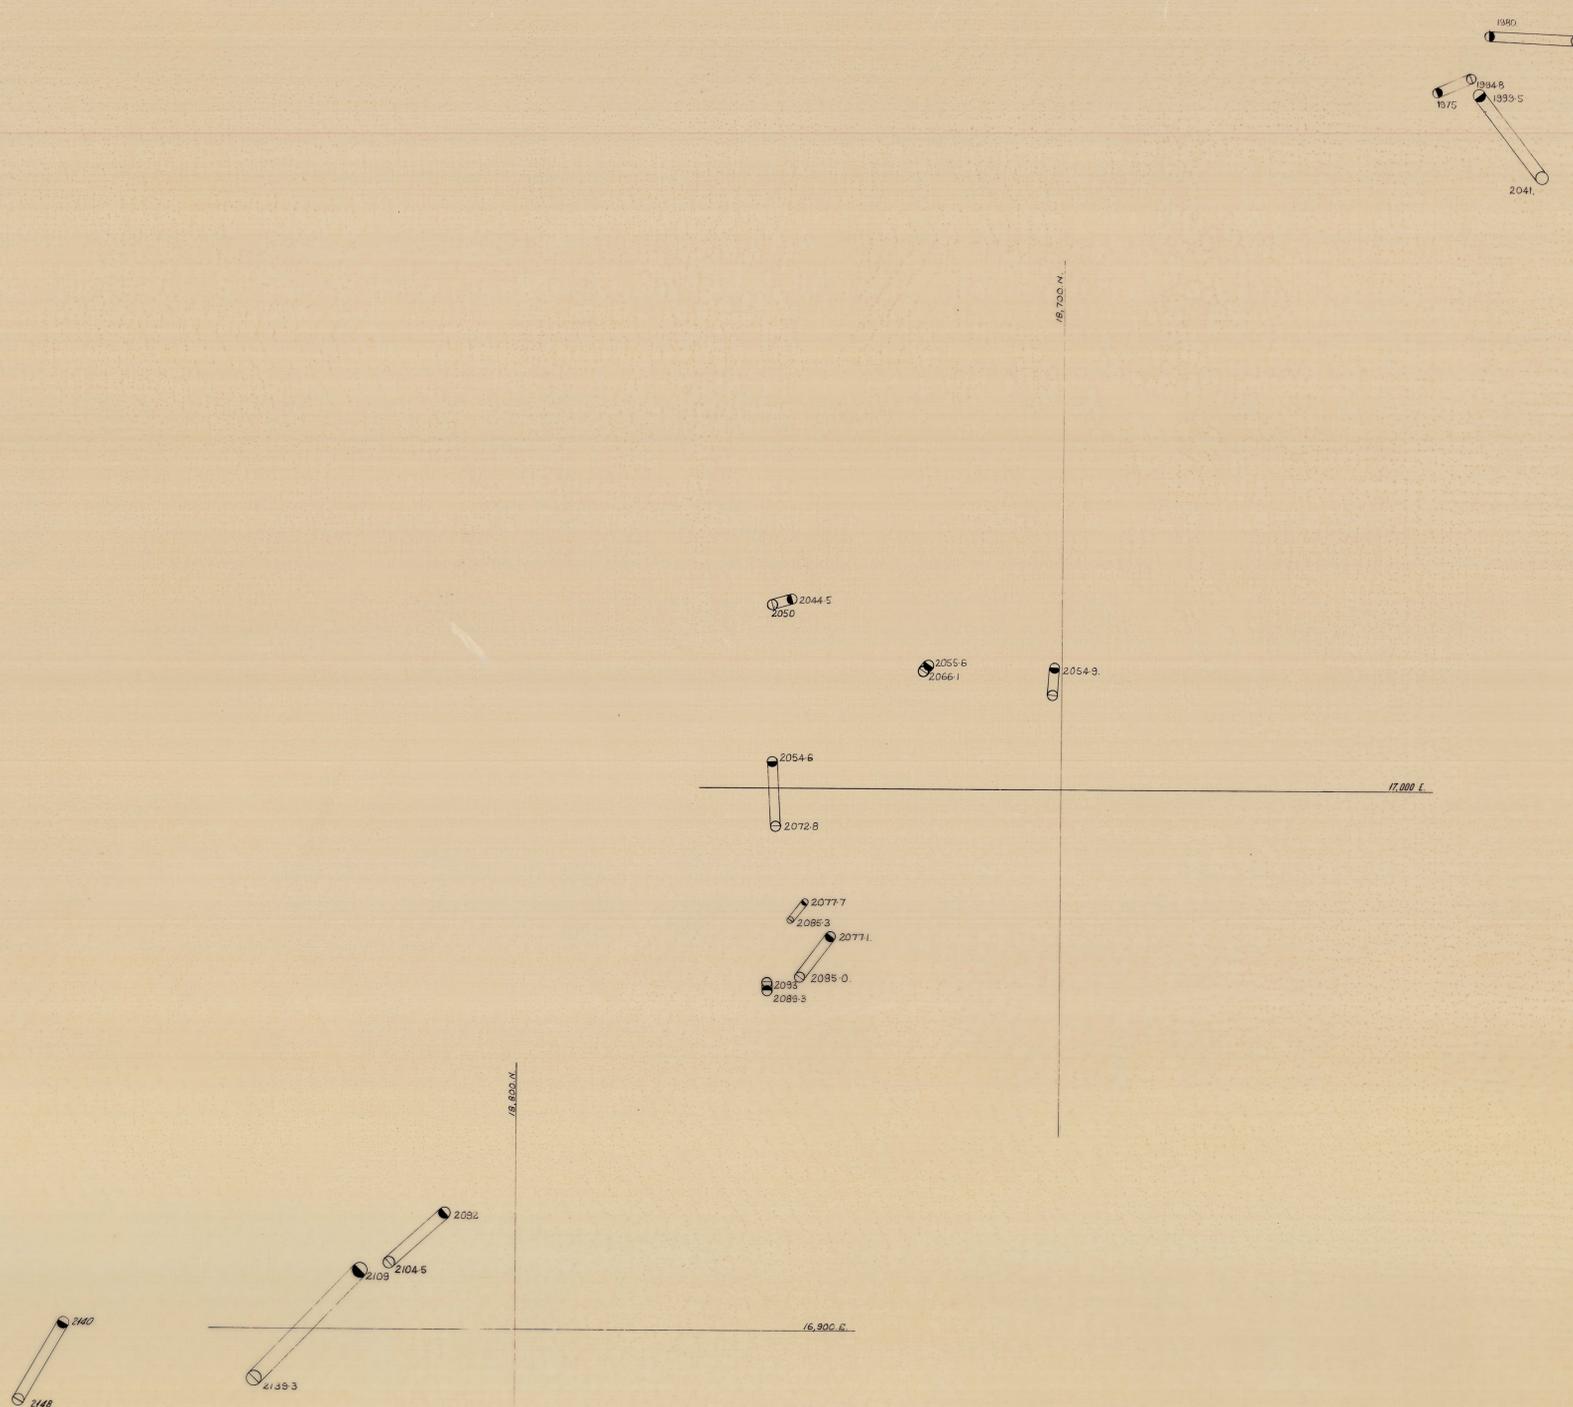

5 cm
0376-287

DATE	MANAGER	SURVEYOR	RENSON LIMITED		DRAWING NO.
8-12-87			SURVEY		
			DRAWN: P.W.K.	DATE: 8-1-78	SCALE: 1:500
			NORTH STEBBINS SLOPE Rises		

83082