


0376-288

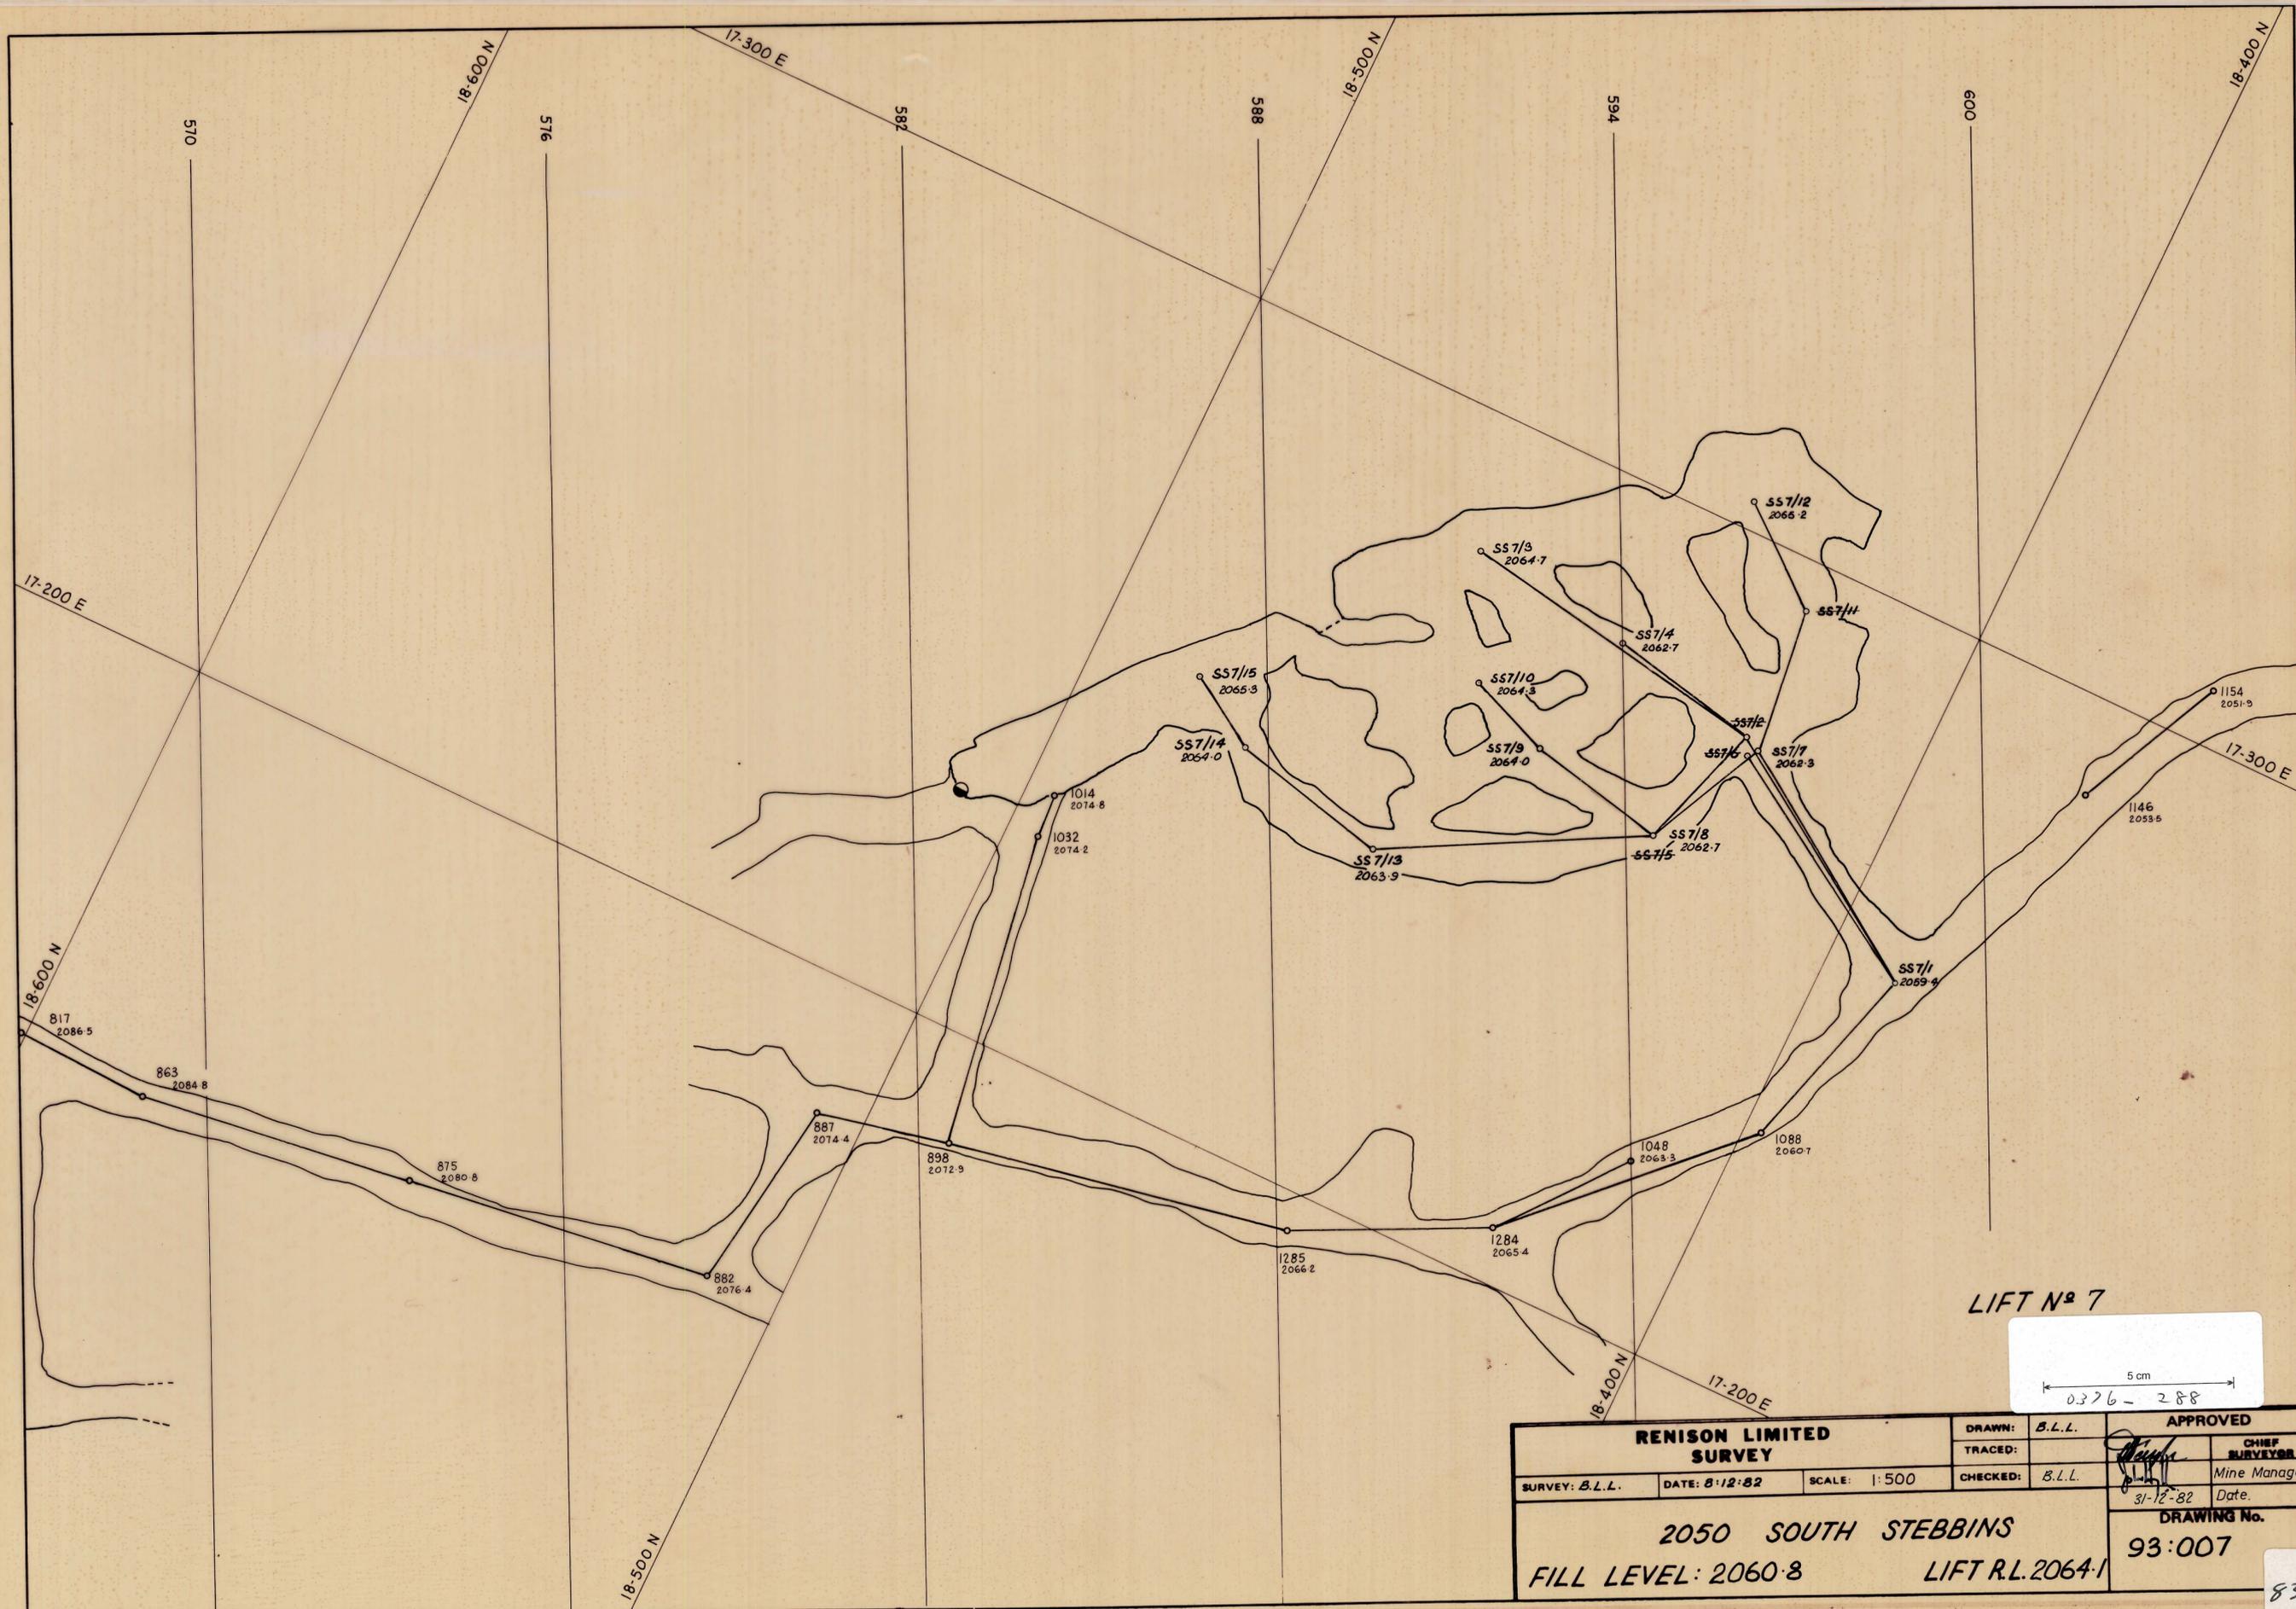

LIFT N^o 7

5 cm
0376-288

RENISON LIMITED SURVEY			DRAWN: B.L.L.	APPROVED <i>[Signature]</i> CHIEF SURVEYOR
			TRACED:	
SURVEY: B.L.L.	DATE: 8-12-82	SCALE: 1:500	CHECKED: B.L.L.	Date: 31-12-82
2050 SOUTH STEBBINS FILL LEVEL: 2060.8			DRAWING No. 93:007	
LIFT R.L. 2064.1				

83119