



0376 - 289

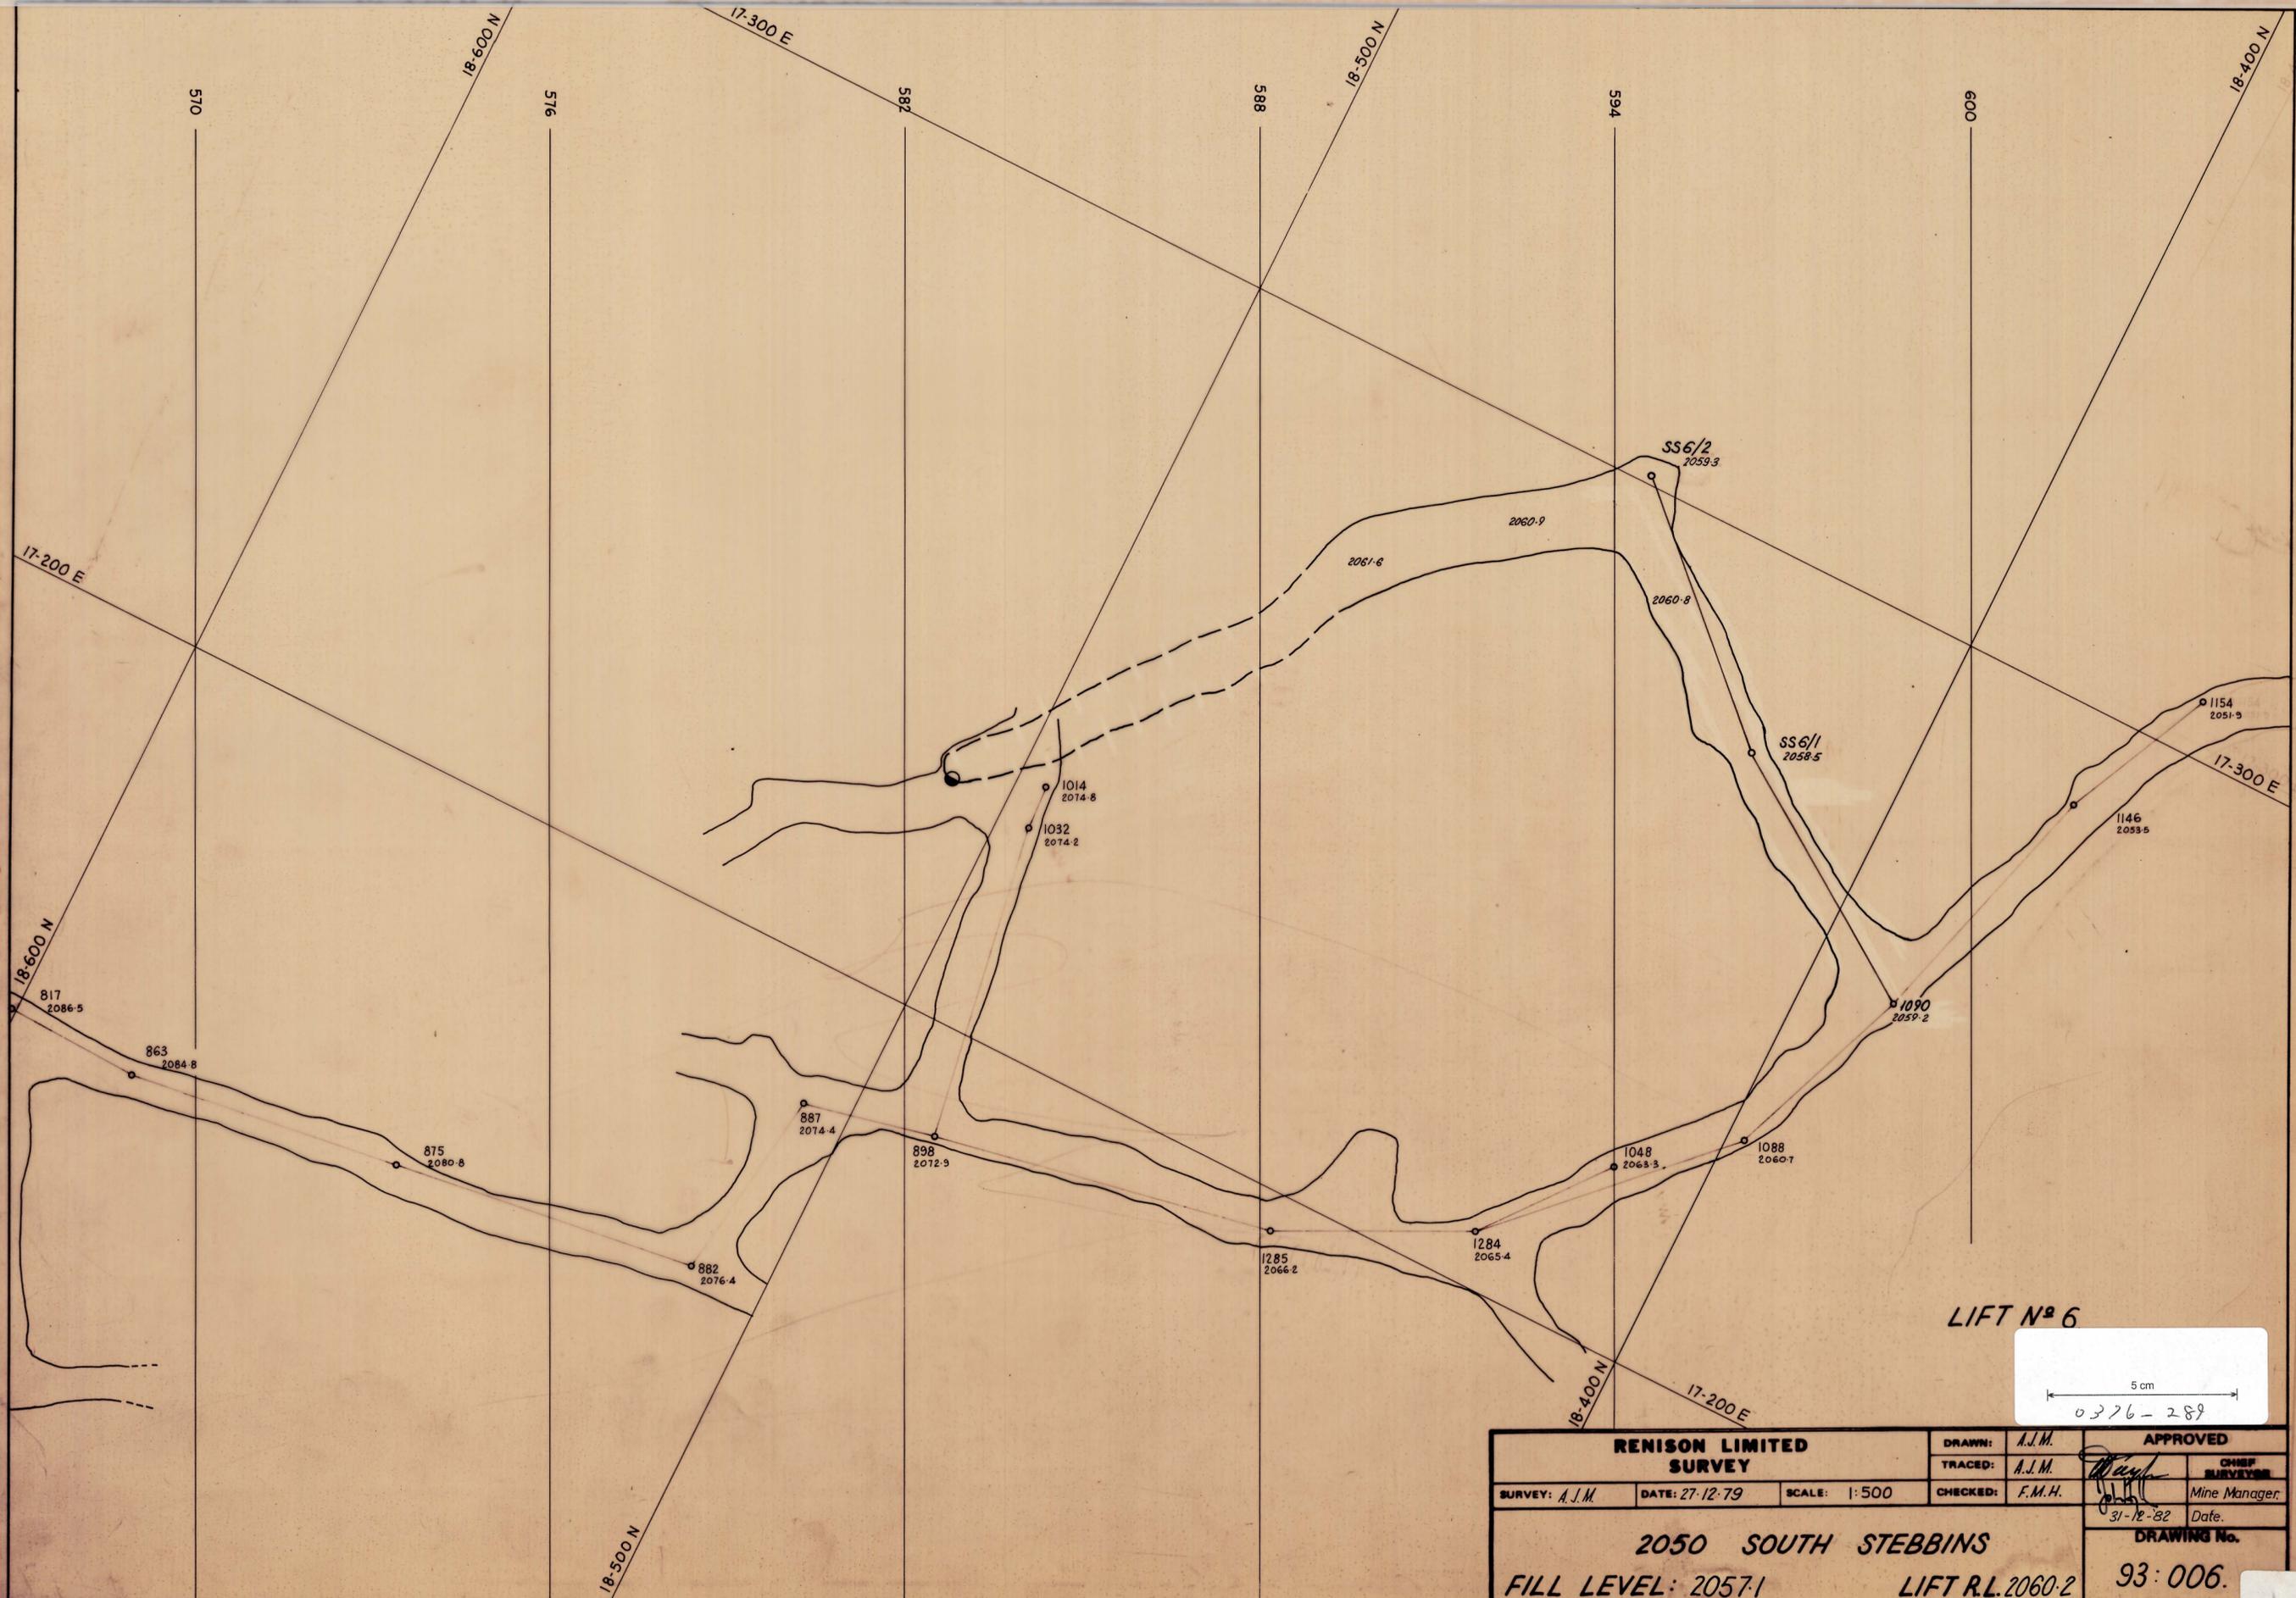

LIFT N° 6

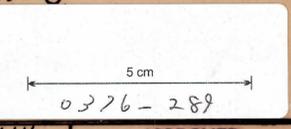

<b>RENISON LIMITED SURVEY</b>			DRAWN: A.J.M.	<b>APPROVED</b>
			TRACED: A.J.M.	
SURVEY: A.J.M.	DATE: 27-12-79	SCALE: 1:500	CHECKED: F.M.H.	Mine Manager.
2050 SOUTH STEBBINS FILL LEVEL: 2057.1			Date. 31-12-82	
			DRAWING No. 93:006.	

8348