


0376-281

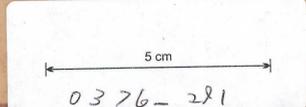

LIFT N° 4.



RENISON LIMITED SURVEY			DRAWN: A.J.M.	APPROVED
			TRACED: J.M.B.	<i>[Signature]</i> CHIEF SURVEYOR
SURVEY: A.J.M.	DATE: 15-1-79	SCALE: 1:500	CHECKED: J.M.B.	Mine Manager.
2050 SOUTH STEBBINS FILL LEVEL: 2055.4			31/12-82	Date.
			DRAWING No. 93:004	

83116