


0376-292

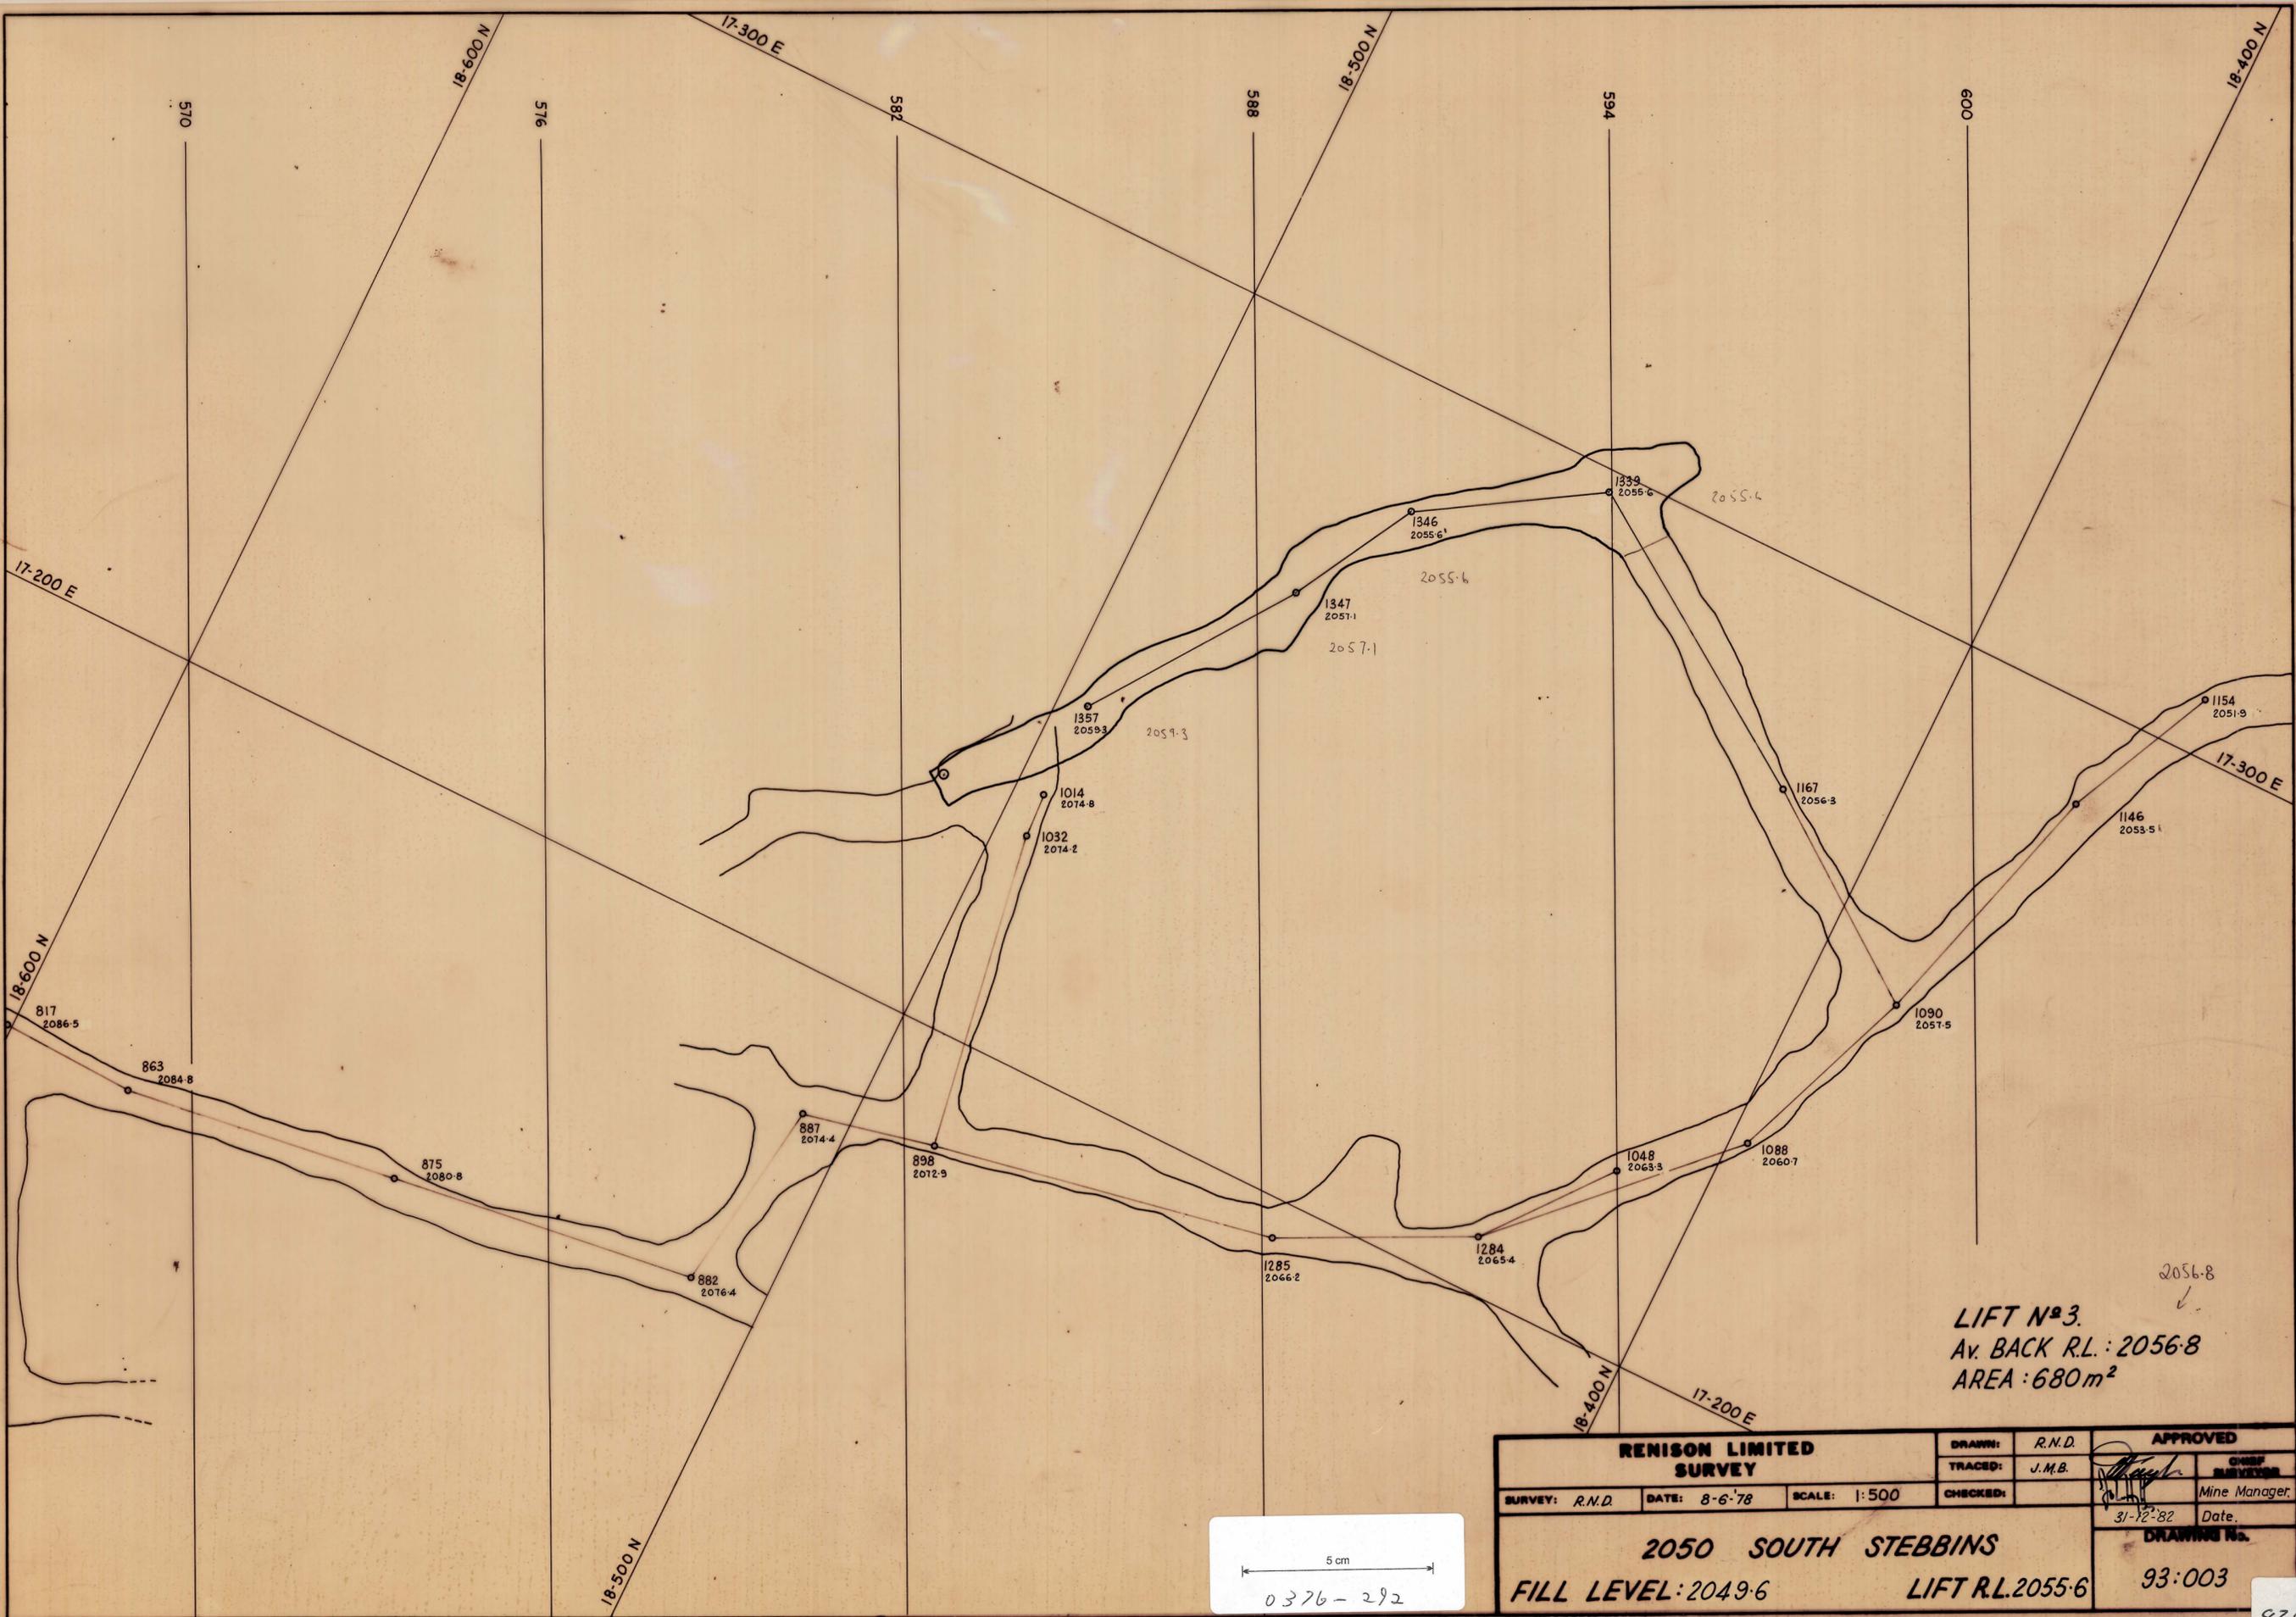

LIFT N^o 3
 Av. BACK R.L.: 2056.8
 AREA: 680m²

RENISON LIMITED SURVEY			DRAWN: R.N.D.	APPROVED	
SURVEY: R.N.D.			TRACED: J.M.B.	CHIEF SURVEYOR	
DATE: 8-6-78			CHECKED:	Mine Manager	
SCALE: 1:500			31-12-82 Date.		
2050 SOUTH STEBBINS				DRAWING No.	
FILL LEVEL: 2049.6				93:003	
LIFT R.L. 2055.6					

5 cm
 0376-292

83115