


0376-293

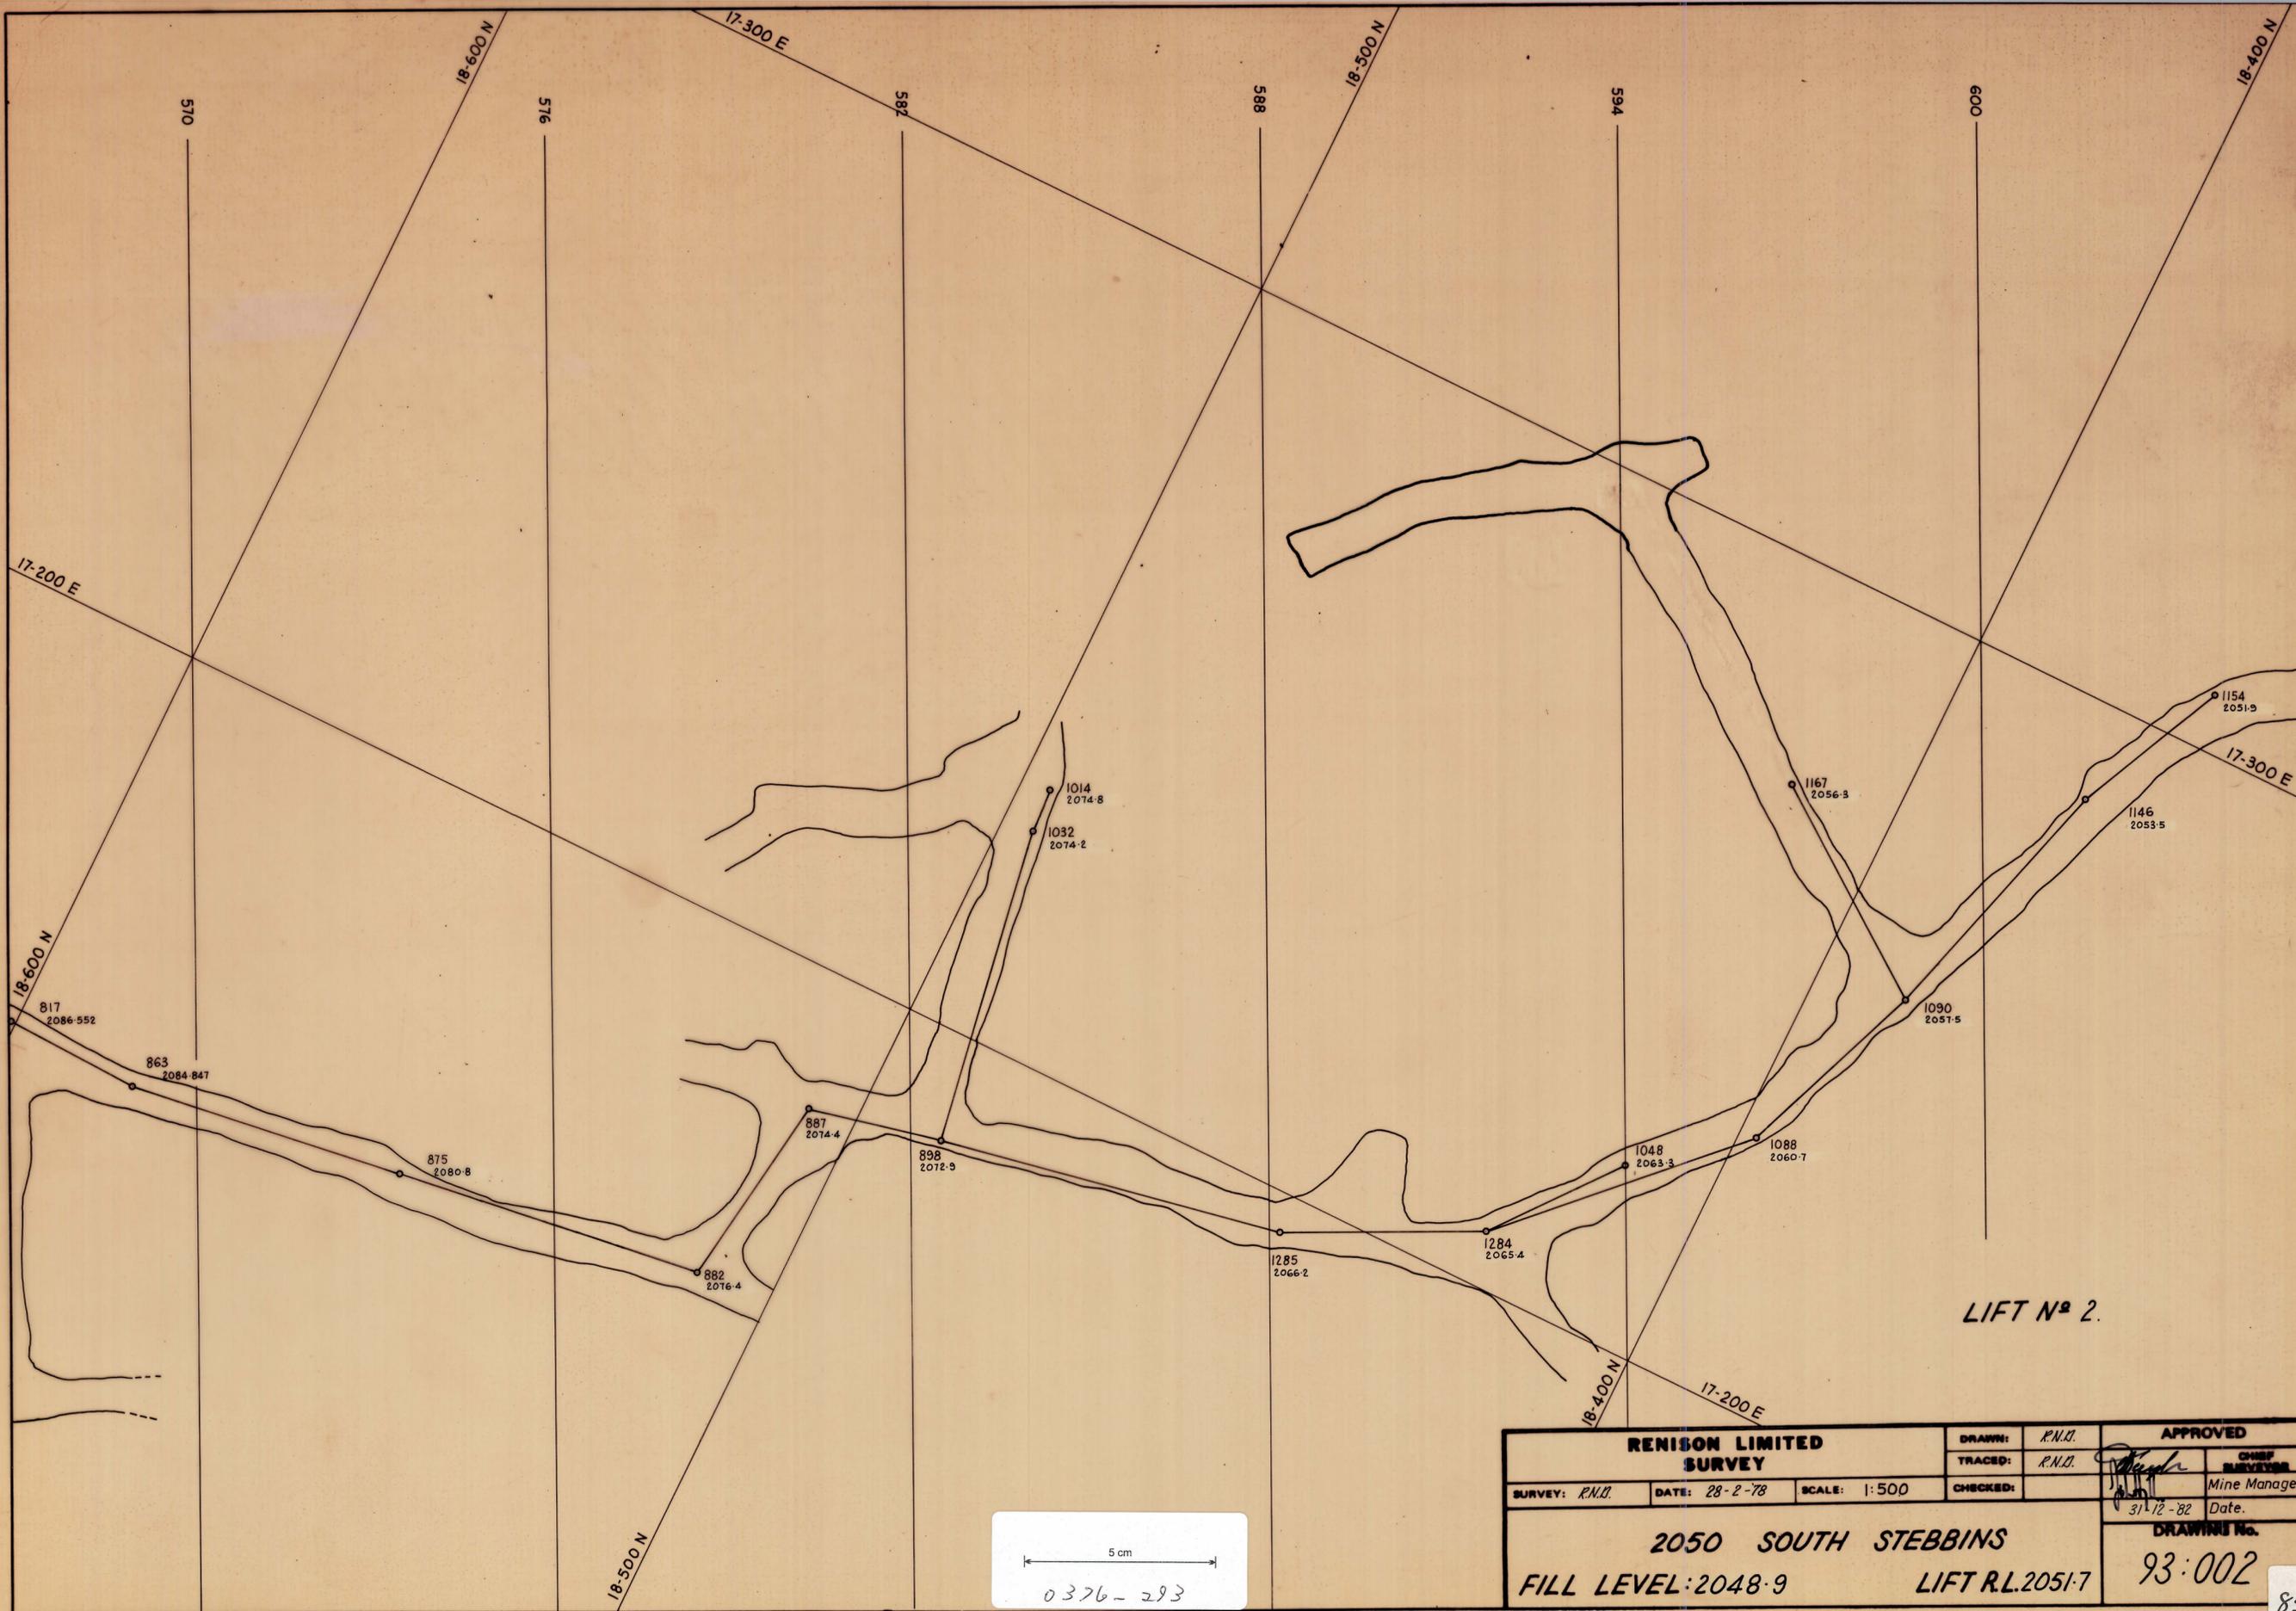

LIFT N° 2.

<b>RENISON LIMITED SURVEY</b>			DRAWN: R.N.D.	<b>APPROVED</b> <i>[Signature]</i> CHIEF SURVEYOR
			TRACED: R.N.D.	
SURVEY: R.N.D.	DATE: 28-2-78	SCALE: 1:500	CHECKED:	Date: 31/12-82
2050 SOUTH STEBBINS			DRAWING No. 93:002	
FILL LEVEL: 2048.9			LIFT R.L. 2051.7	

5 cm

0376-293

83114