


0376-295

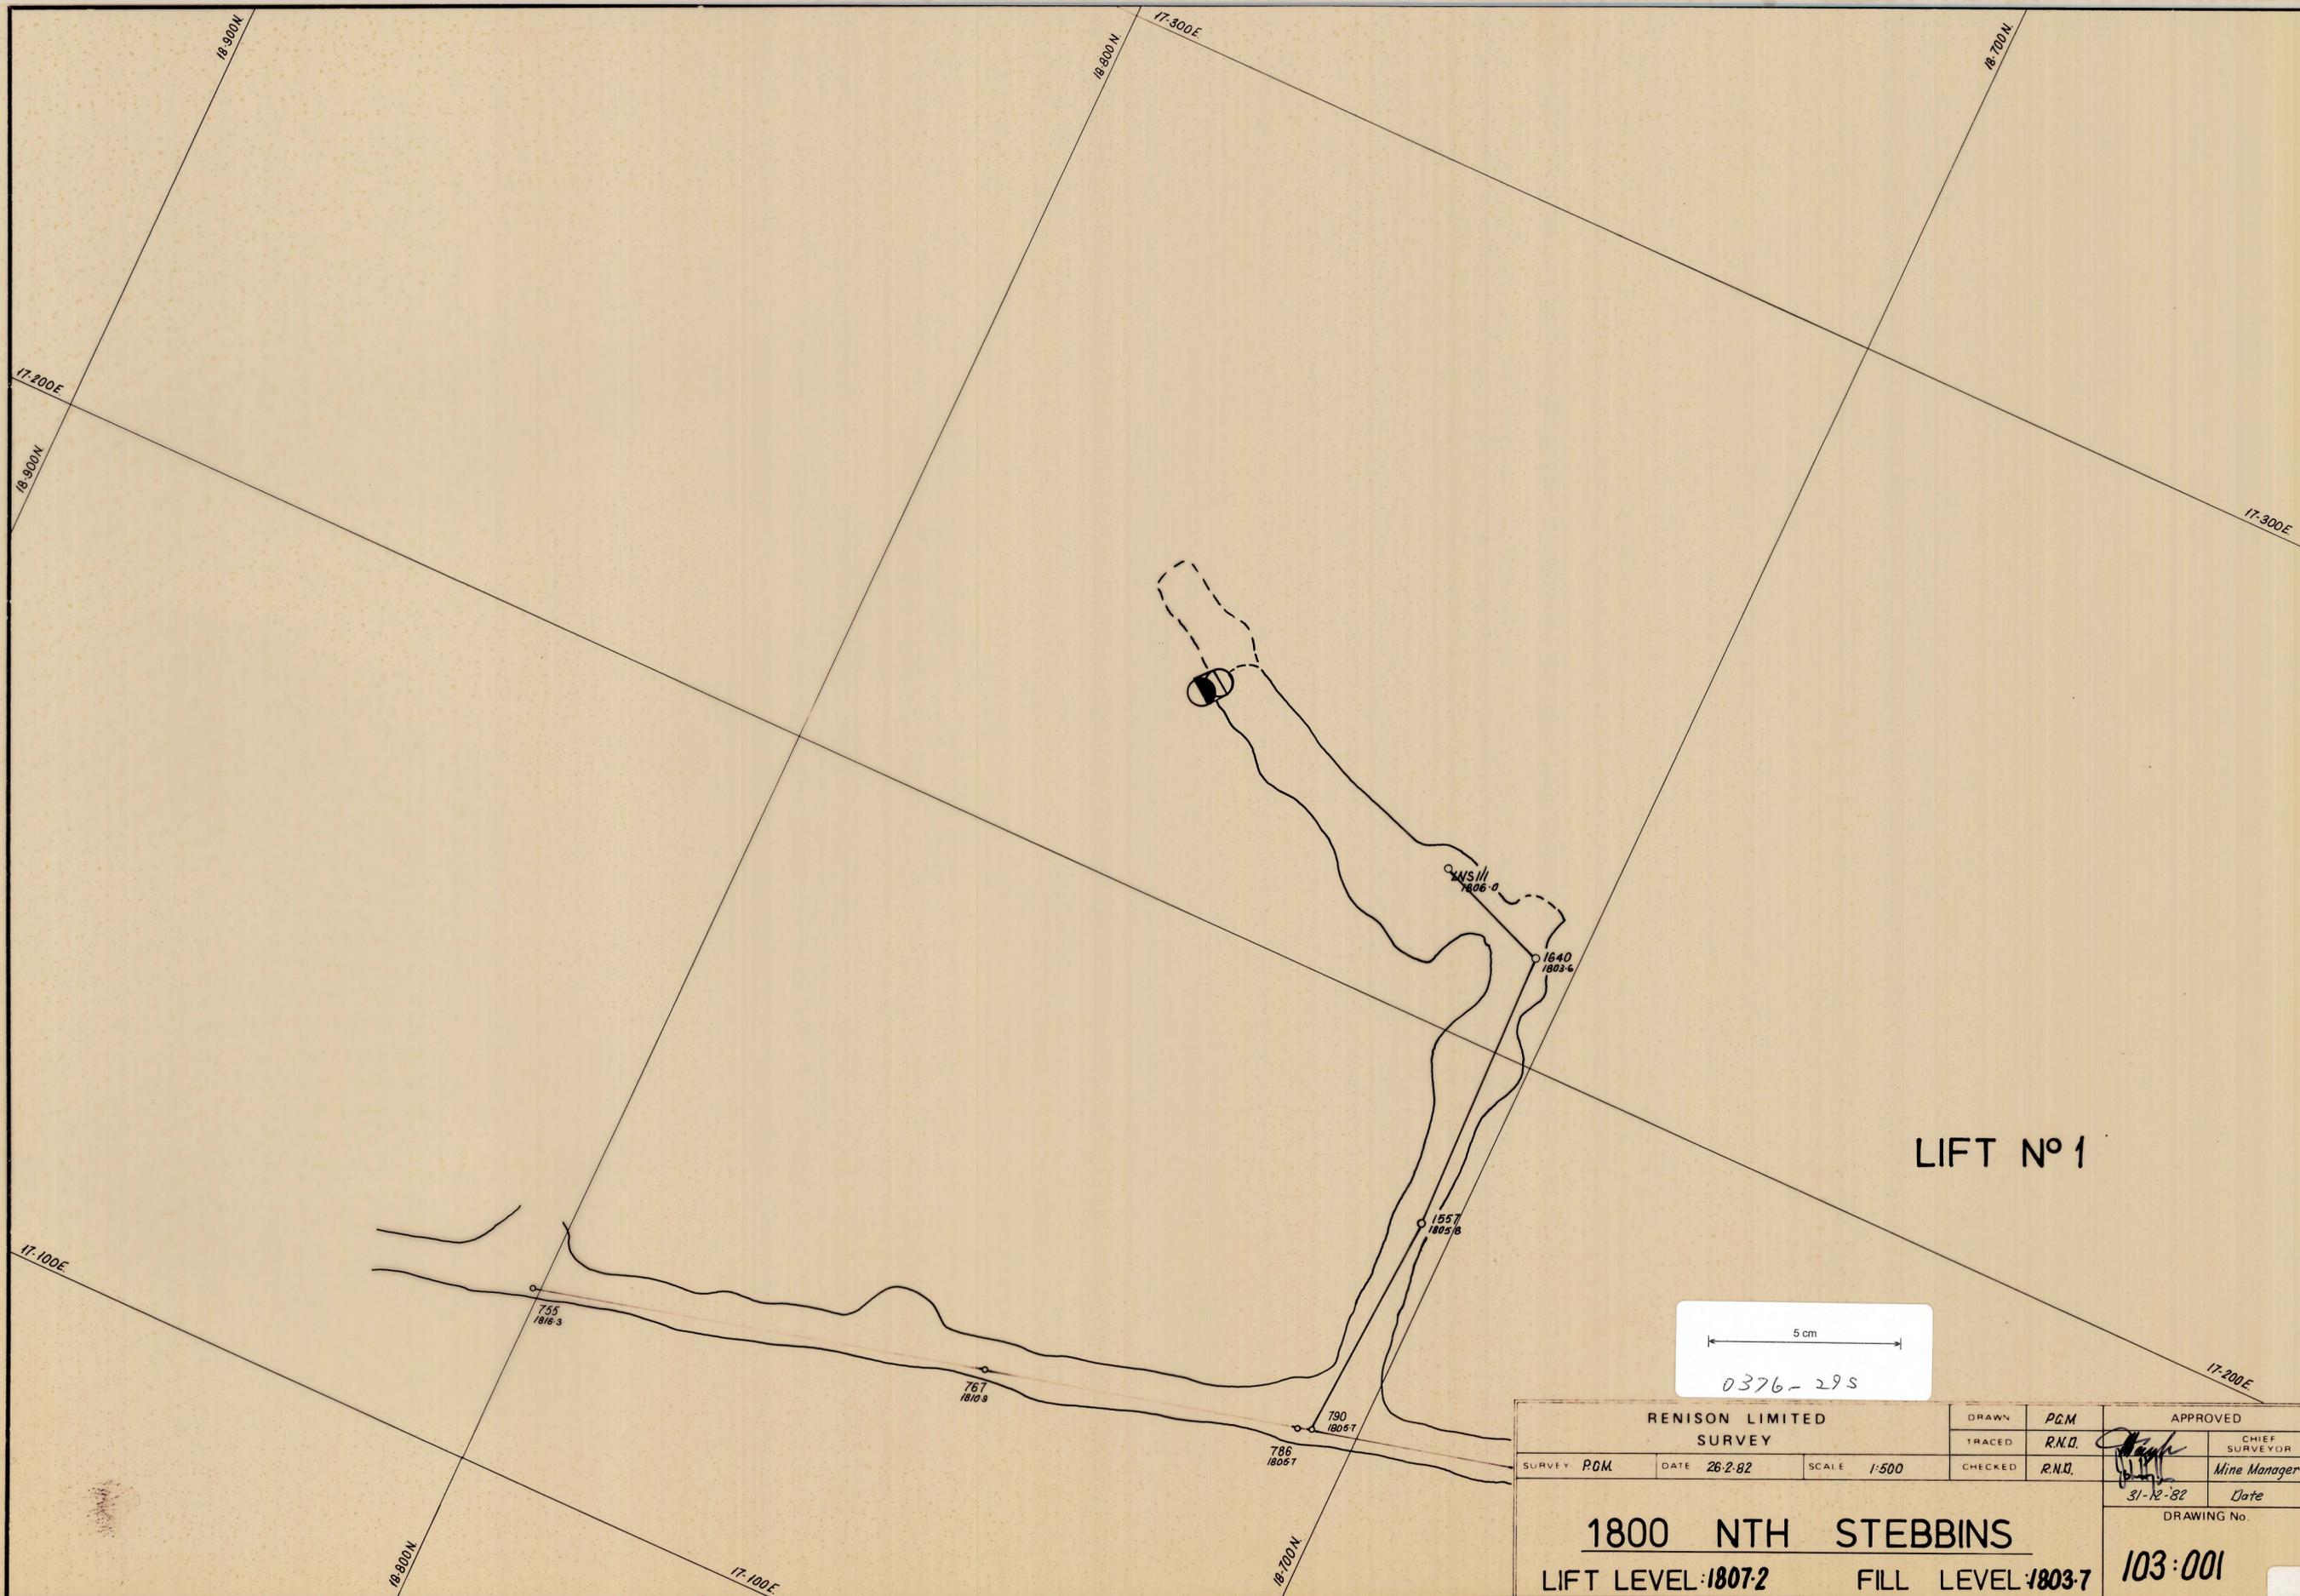

LIFT N° 1

5 cm

0376-295

RENISON LIMITED SURVEY			DRAWN	PGM	APPROVED	
			TRACED	R.N.D.	CHIEF SURVEYOR	
SURVEY	PGM	DATE 26-2-82	CHECKED	R.N.D.	Mine Manager	
					31-12-82	Date
					DRAWING No.	
1800 NTH STEBBINS					103:001	
LIFT LEVEL: 1807.2			FILL LEVEL: 1803.7			

83112