


0376-296

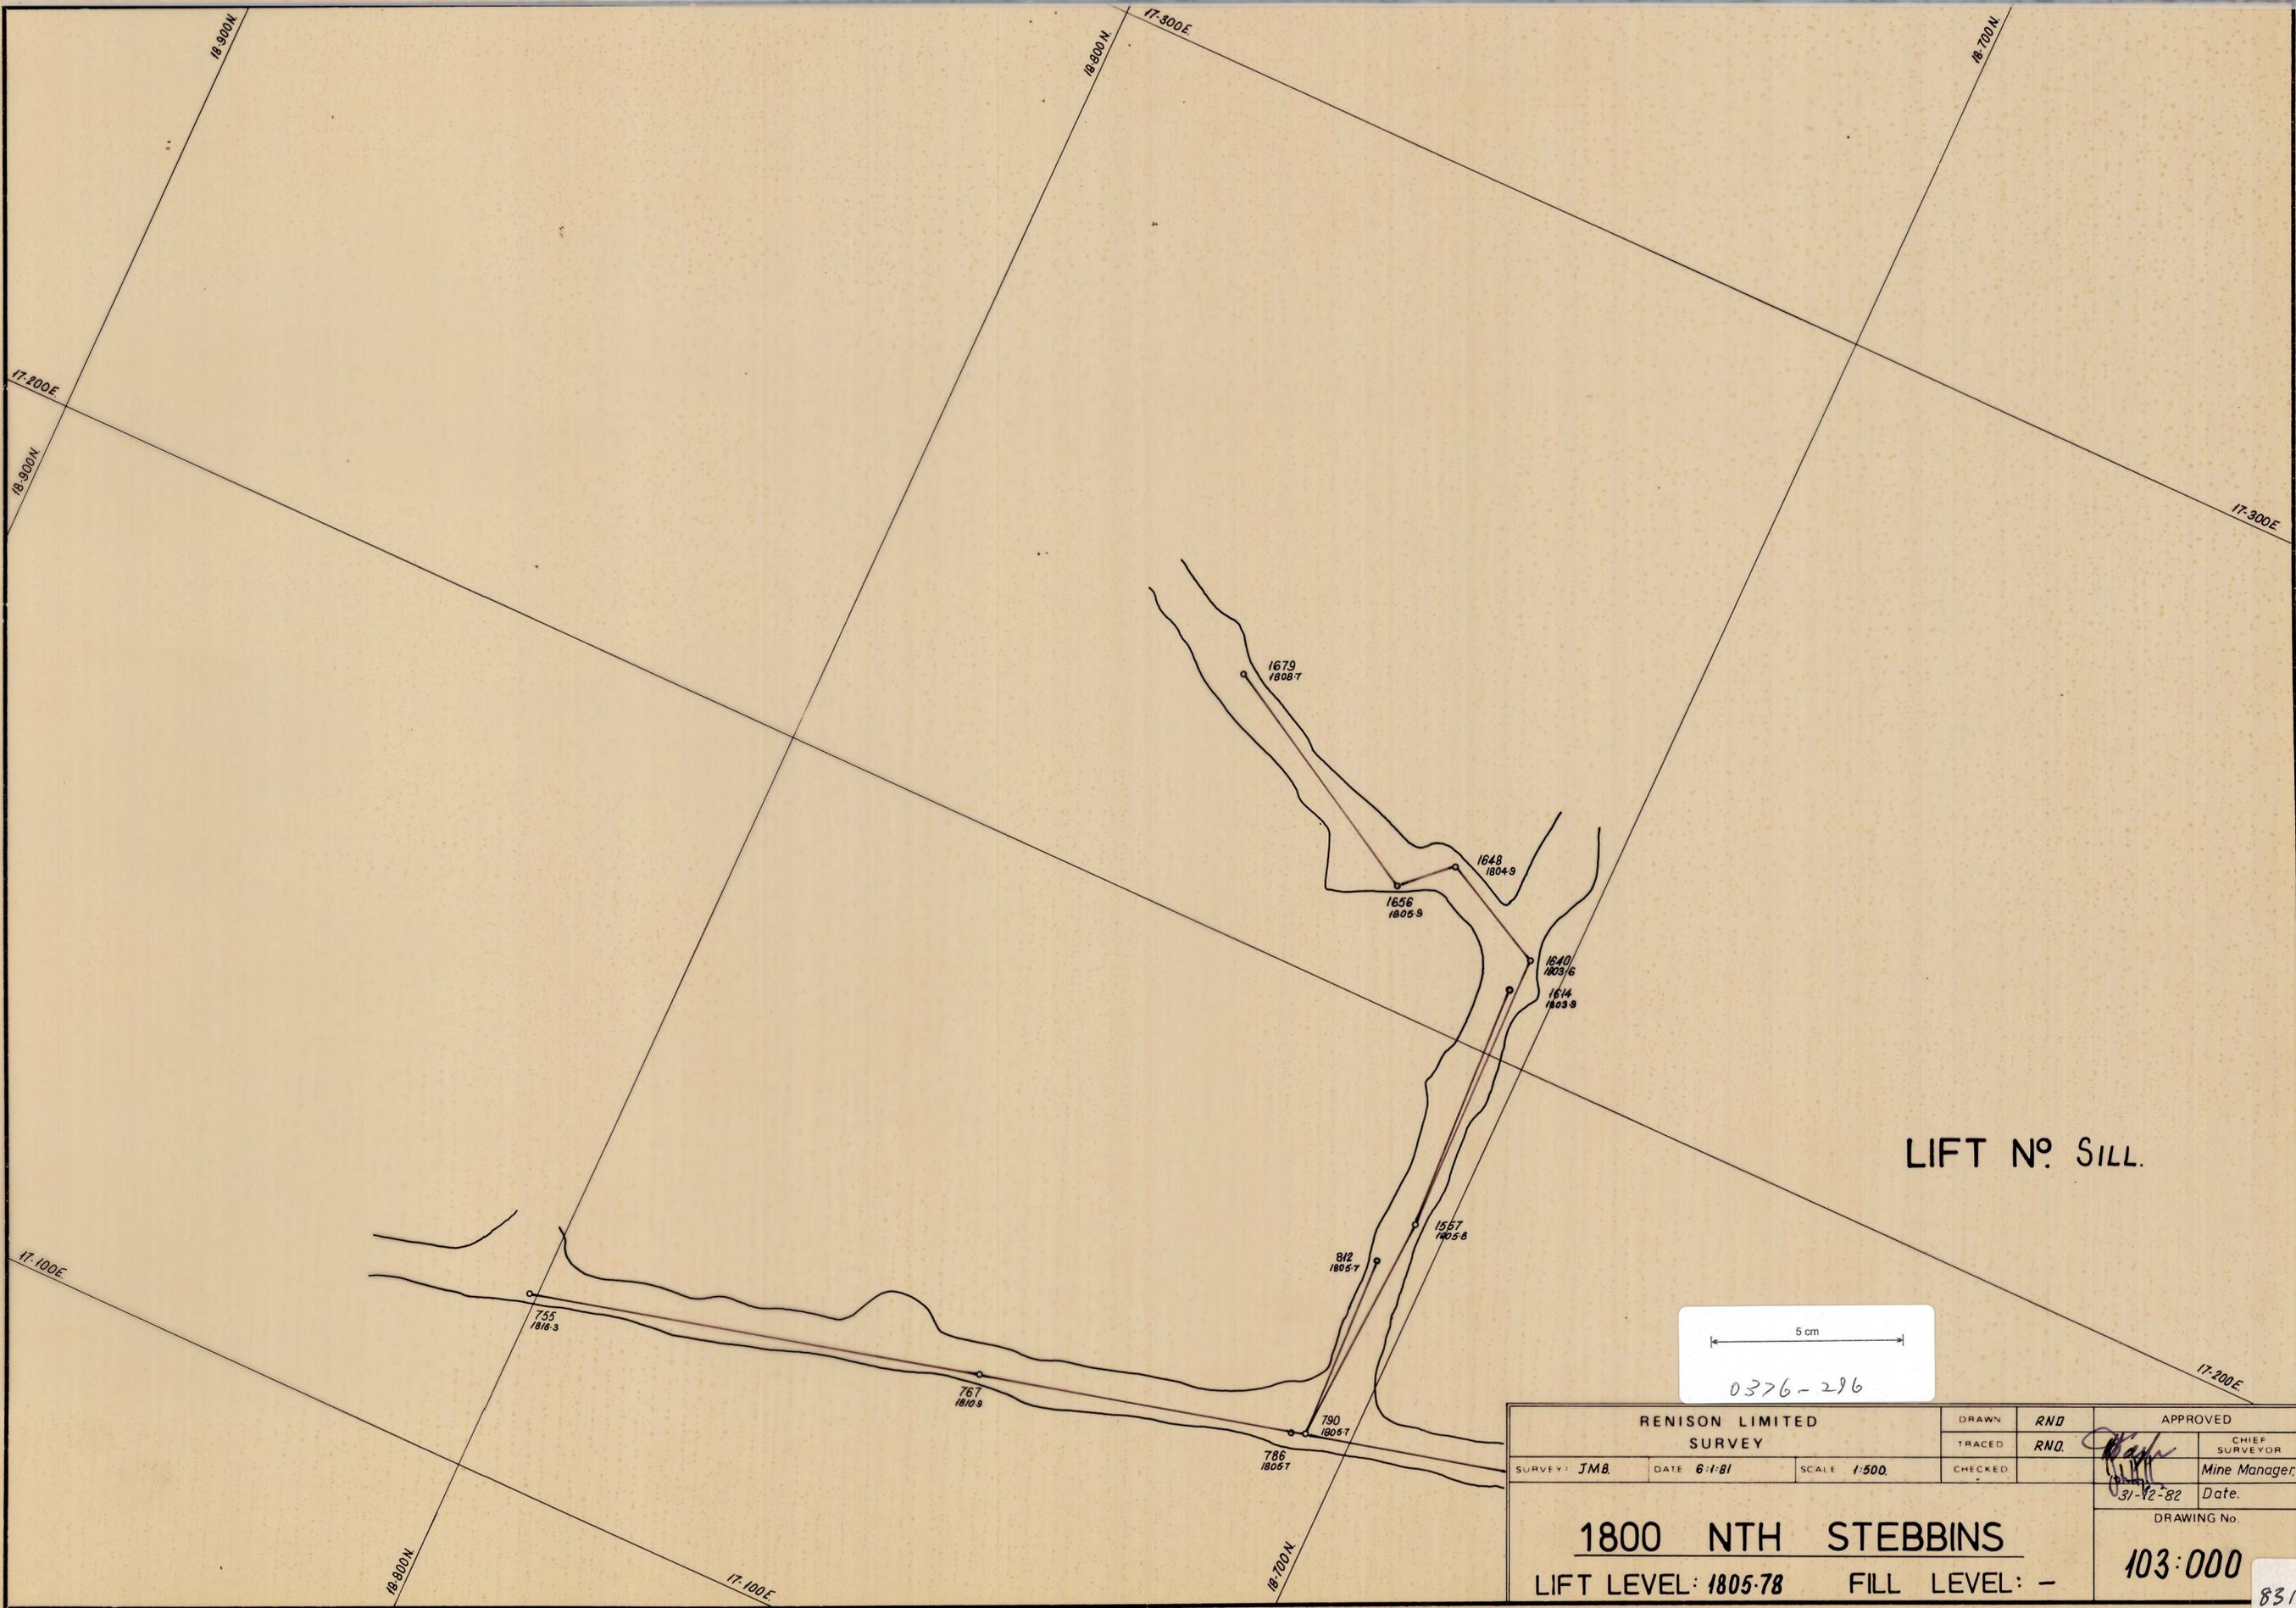

5 cm

0376-296

RENISON LIMITED SURVEY			DRAWN <i>RND</i>	APPROVED
			TRACED <i>RND</i>	CHIEF SURVEYOR
SURVEY: <i>JMB</i>	DATE: <i>6-1-81</i>	SCALE: <i>1:500</i>	CHECKED	Mine Manager
				Date: <i>31-12-82</i>
1800 NTH STEBBINS				DRAWING No.
LIFT LEVEL: <i>1805-78</i>		FILL LEVEL: <i>-</i>		103:000

8311