




LIFT No 18

RENISON LIMITED SURVEY			DRAWN	A.J.M.	APPROVED	
			TRACED	F.M.H.	CHIEF SURVEYOR	
SURVEY: A.J.M. DATE: 17-3-80 SCALE: 1:500			CHECKED	F.M.H.	Date: 31-12-82	
<u>1900 NORTH STEBBINS</u>					DRAWING No.	
FILL LEVEL: 1949.0			LIFT R.L.: 1951.6		<b>7:015</b>	

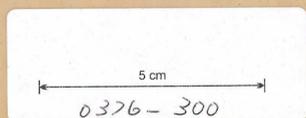

83107