


AVERAGE BACK RL:  
AREA:

LIFT NO. 15.

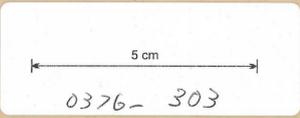

REXON LIMITED SURVEY			DRAWN	A.J.M.	APPROVED	
			TRACED	J.B.	<i>[Signature]</i>	CHIEF SURVEYOR
DRAWN BY: A.J.M.	DATE: 22-1-79	SCALE: 1/500	CHECKED	J.B.	<i>[Signature]</i>	Mine Manager
1900 NORTH STEBBINS					DRAWING No.	
FILL LEVEL: 1938.3					LIFT RL: 1941.6	
					7-012	

83104