
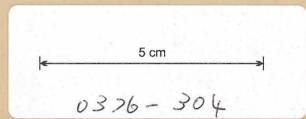


AVERAGE BACK RL: 1938.8 (N.S.)

AREA:

LIFT NO. 14

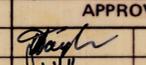

RENISON LIMITED SURVEY SURVEY: R.N.D. & P.E.C. DATE: 2-6-78 SCALE: 1:500.			DRAWN: R.N.D. TRACED: F.M.H.	APPROVED  CHIEF SURVEYOR
			CHECKED: F.M.H.	Mine Manager Date: 31-12-82
1900 NORTH STEBBINS FILL LEVEL: 1934.3 LIFT RL: 1938.8			DRAWING No. 7:011	