


AREA:

LIFT NO. 13.

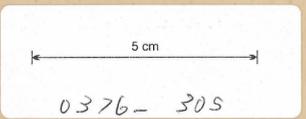

RENISON LIMITED SURVEY SURVEY: R.N.D. & P.A.T. DATE: 4-1-78 SCALE: 1:500.			DRAWN: R.N.D. TRACED: F.M.H. CHECKED: F.M.H.	APPROVED CHIEF SURVEYOR Mine Manager
			1900 NORTH STEBBINS FILL LEVEL: 1932.4 LIFT RL: 1937.2	

83102