


0376-307

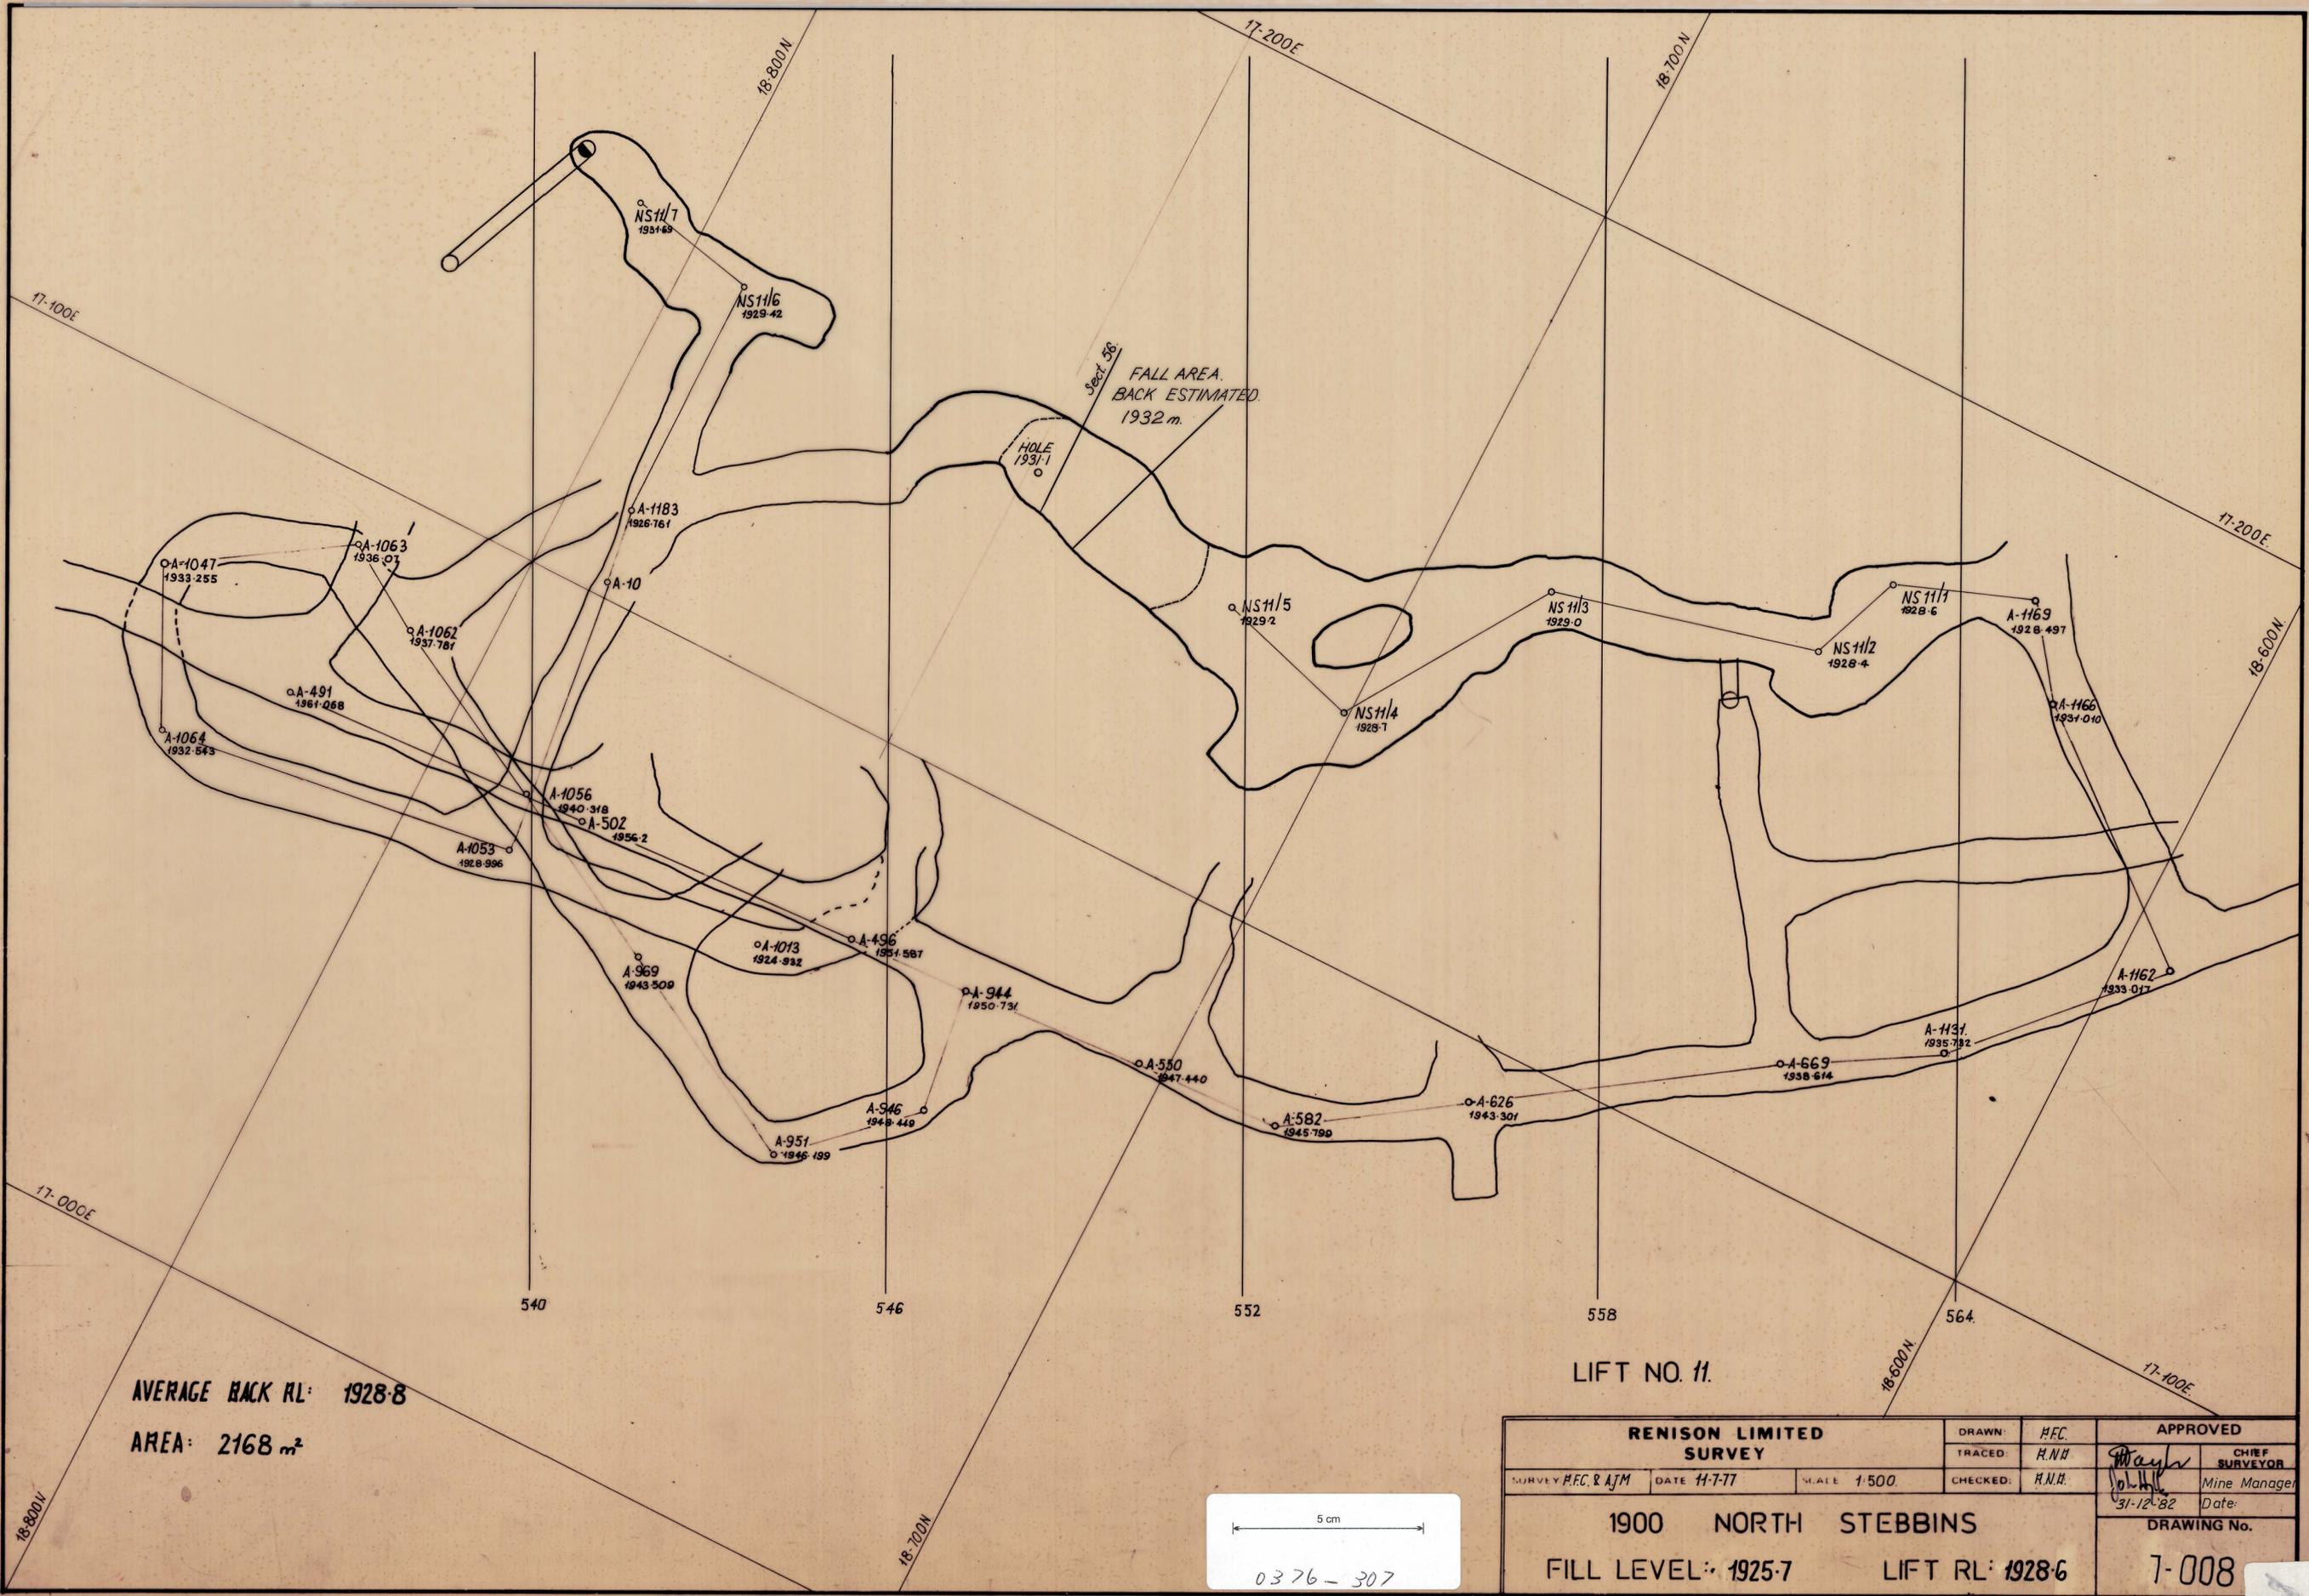

AVERAGE BACK RL: 1928.8
 AREA: 2168 m²

LIFT NO. 11.

RENISON LIMITED SURVEY SURVEY P.F.C. & A.J.M. DATE 11-7-77 SCALE 1:500			DRAWN: H.F.C. TRACED: R.N.H.	APPROVED <i>[Signature]</i> CHIEF SURVEYOR
			CHECKED: R.N.H.	Mine Manager Date: 31-12-82
1900 NORTH STEBBINS FILL LEVEL: 1925.7 LIFT RL: 1928.6			DRAWING No. 7-008	

5 cm
 0376-307

83100