


0376-309

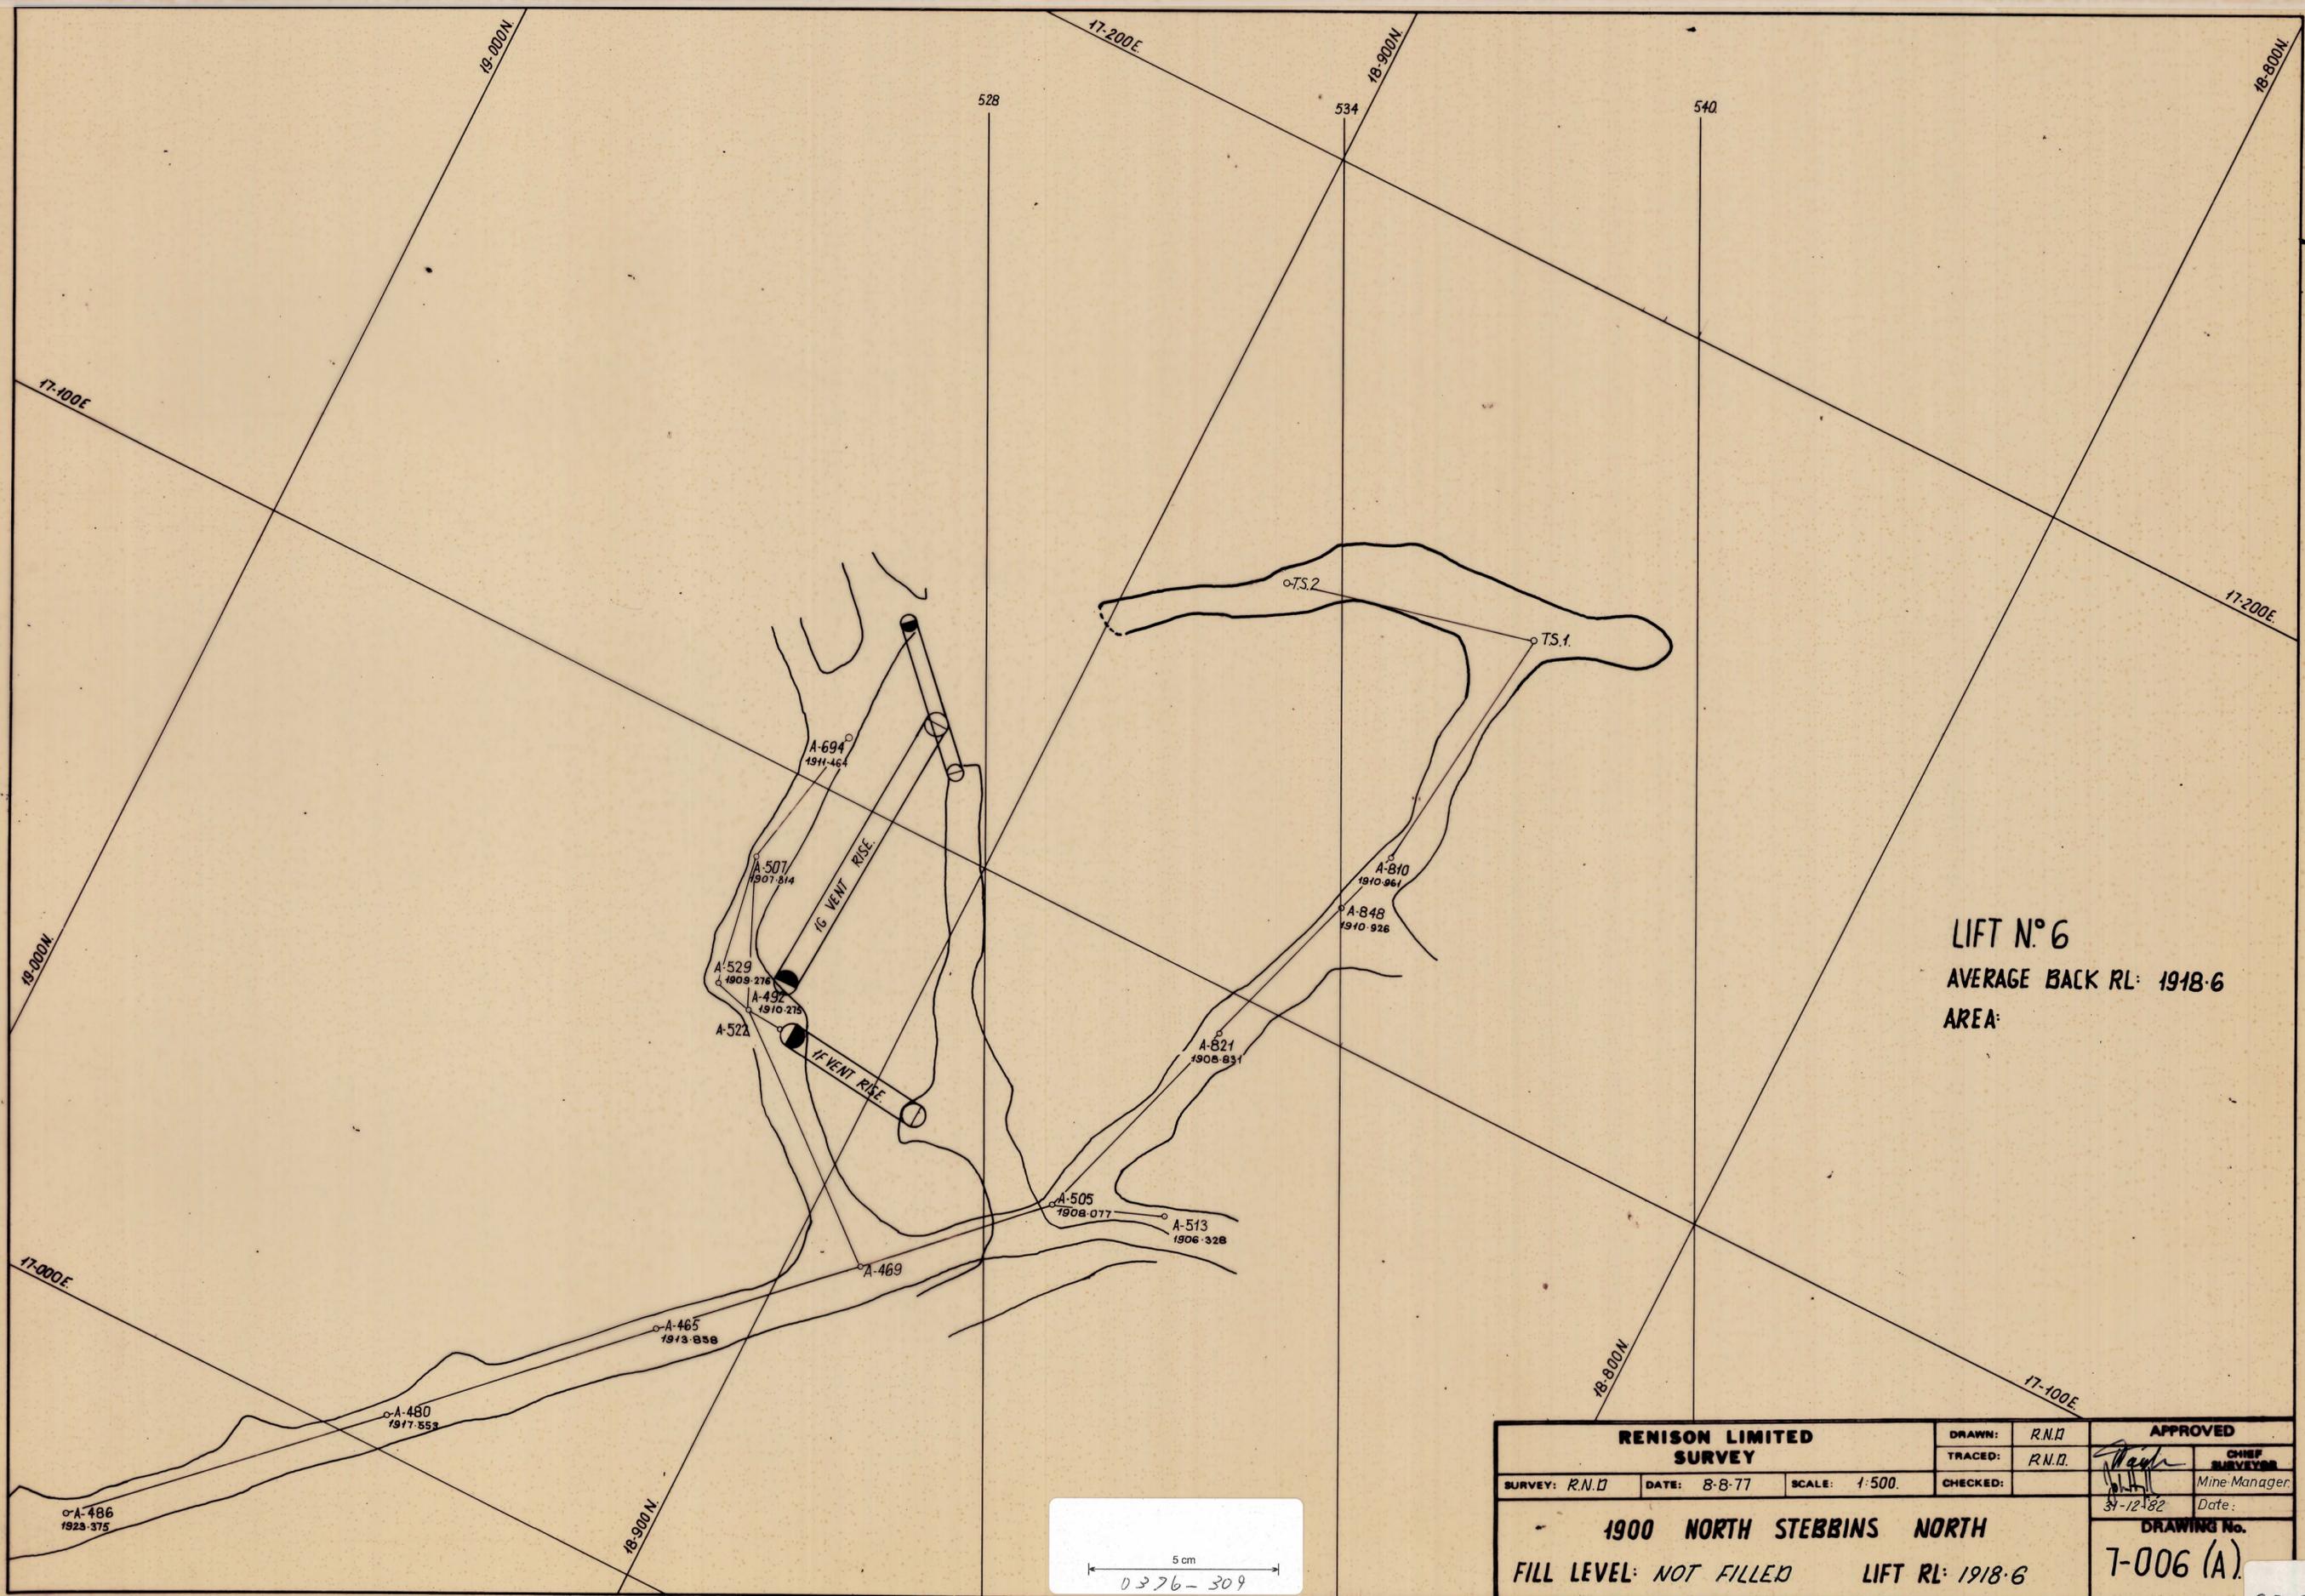

LIFT N° 6
 AVERAGE BACK RL: 1918.6
 AREA:

RENISON LIMITED SURVEY			DRAWN: R.N.D.	APPROVED	
SURVEY: R.N.D.			TRACED: R.N.D.	 <small>CHIEF SURVEYOR</small>	
DATE: 8-8-77	SCALE: 1:500	CHECKED:	<small>Mine Manager</small> <small>31-12-82</small> <small>Date:</small>		
1900 NORTH STEBBINS NORTH FILL LEVEL: NOT FILLED LIFT RL: 1918.6				DRAWING No. 7-006 (A)	

5 cm
 0376-309

83098